


# Large Pail Denester:

- Mechanical General Arrangement Drawings
- Electrical Drawings

## GA Drawings

### Large Pail Denester


#### Main Assembly

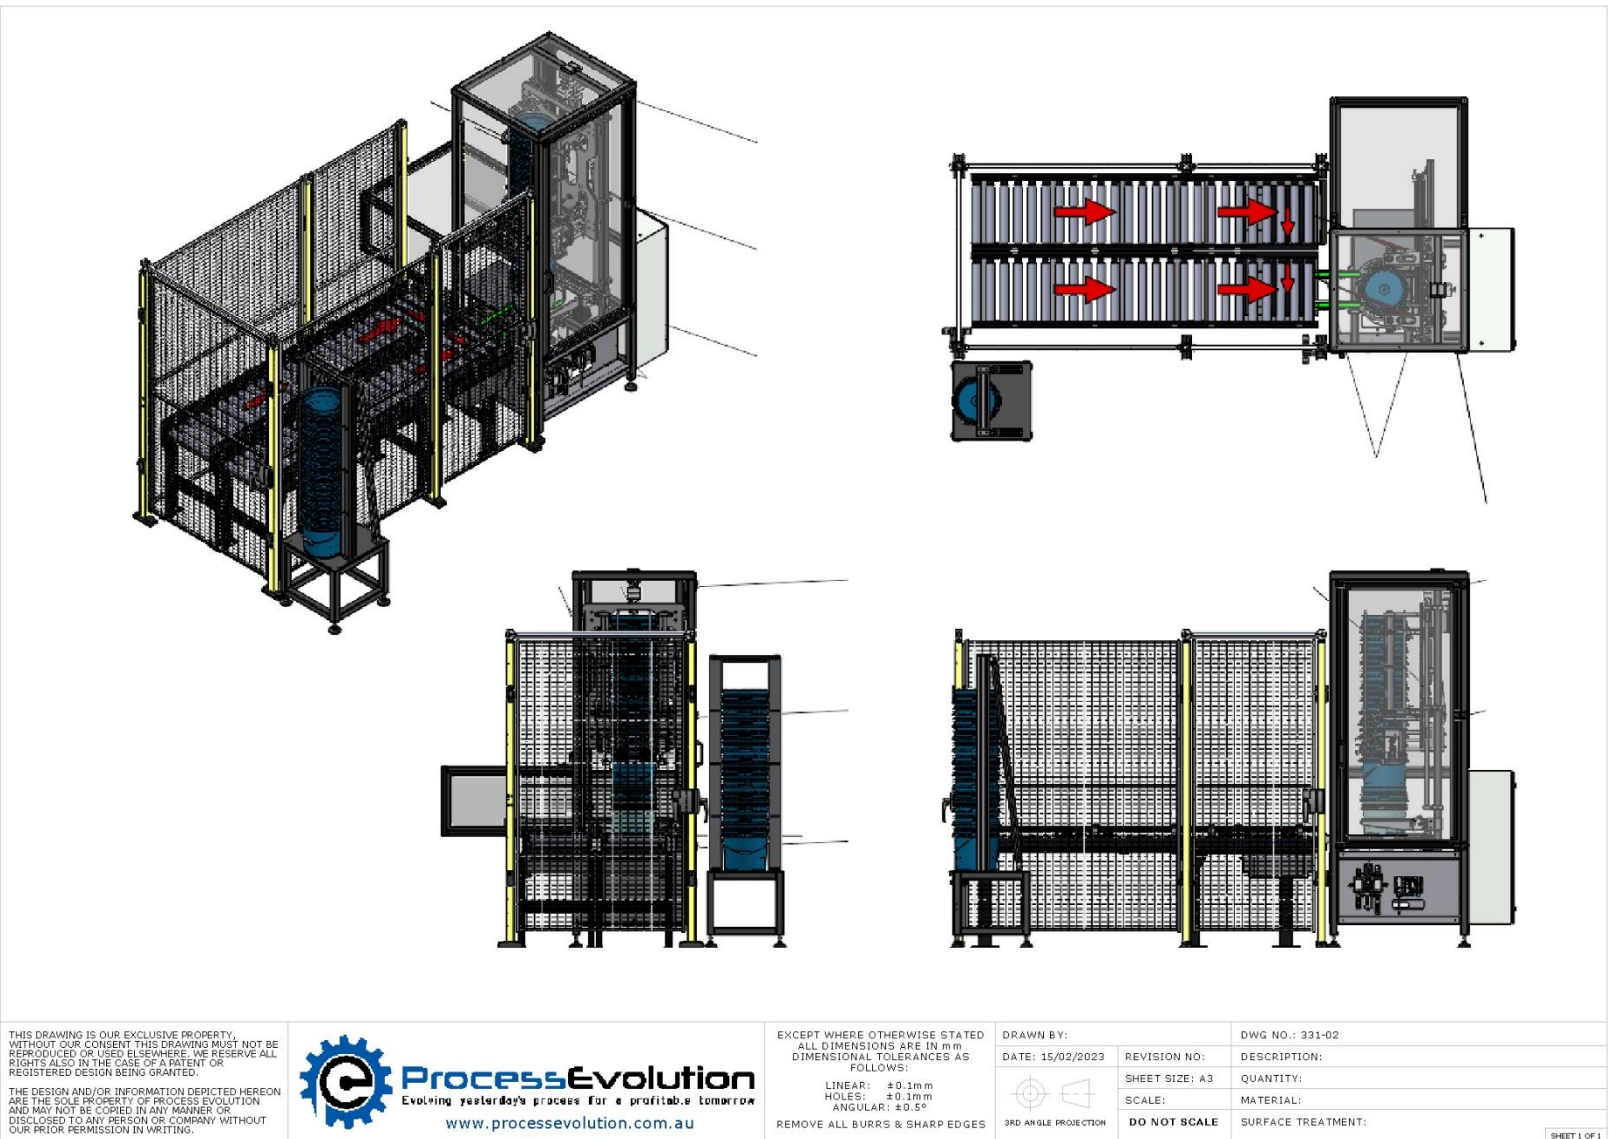



## GA Drawings

### Handle Orientating Jig

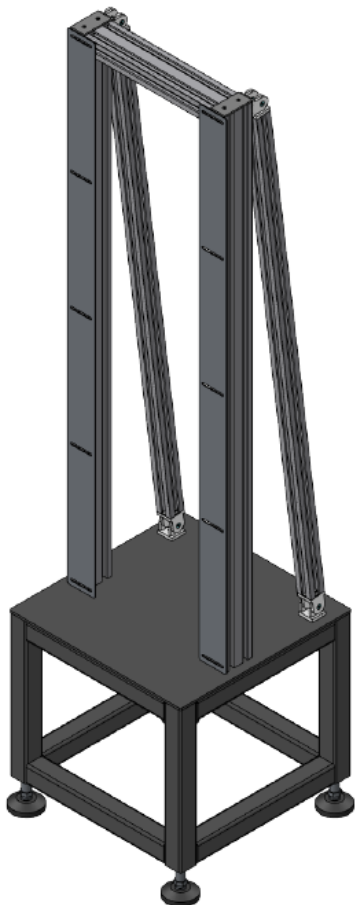

ITEM NO.	PART NUMBER	Description	Vendor	QTY.
1	Robotunits GUS_4041 (45)	GUS 4041	Robotunits	2
2	Robotunits GUS_4041 (45)	GUS 4041	Robotunits	2
3	331-240-01	Frame	ProEvo - Fab	1
4	331-240-02	Base Plate	ProEvo - SM	1
5	331-240-05	Handle Alignment Bar	ProEvo - SM	2
6	331-240-03	Extrusion Vertical Member	Robotunits	2
7	331-240-04	Extrusion Cross Member	Robotunits	1
8	331-240-06	Extrusion Support Member	Robotunits	2
9	LVR8020100SSS	Machine Feet	Richmond Castors	4
10	CAP 4081	End Cap 40x80	Robotunits	2

THIS DRAWING IS OUR EXCLUSIVE PROPERTY. WITHOUT OUR CONSENT THIS DRAWING MUST NOT BE REPRODUCED OR USED ELSEWHERE. WE RESERVE ALL RIGHTS ALSO IN THE CASE OF A PATENT OR REGISTERED DESIGN BEING GRANTED.

THE DESIGN AND/OR INFORMATION DEPICTED HEREON ARE THE SOLE PROPERTY OF PROCESS EVOLUTION AND MAY NOT BE COPIED IN ANY MANNER OR DISCLOSED TO ANY PERSON OR COMPANY WITHOUT OUR PRIOR PERMISSION IN WRITING.



**ProcessEvolution**  
Evolving yesterday's process for a profitable tomorrow  
[www.processevolution.com.au](http://www.processevolution.com.au)

EXCEPT WHERE OTHERWISE STATED  
ALL DIMENSIONS ARE IN mm  
DIMENSIONAL TOLERANCES AS  
FOLLOWS:  
LINEAR:  $\pm 0.1\text{mm}$   
HOLES:  $\pm 0.1\text{mm}$   
ANGULAR:  $\pm 0.5^\circ$   
REMOVE ALL BURRS & SHARP EDGES

DRAWN BY:

DATE: 3/03/2023



3RD ANGLE PROJECTION

REVISION NO:

SHEET SIZE: A3

SCALE:

**DO NOT SCALE**

DWG NO.: 331-240

DESCRIPTION: Large Pail Handle Orientation Jig

QUANTITY:

MATERIAL:


SURFACE TREATMENT:

SHEET 1 OF 1



GA Drawings

Pail Stack In-Feed Conveyors

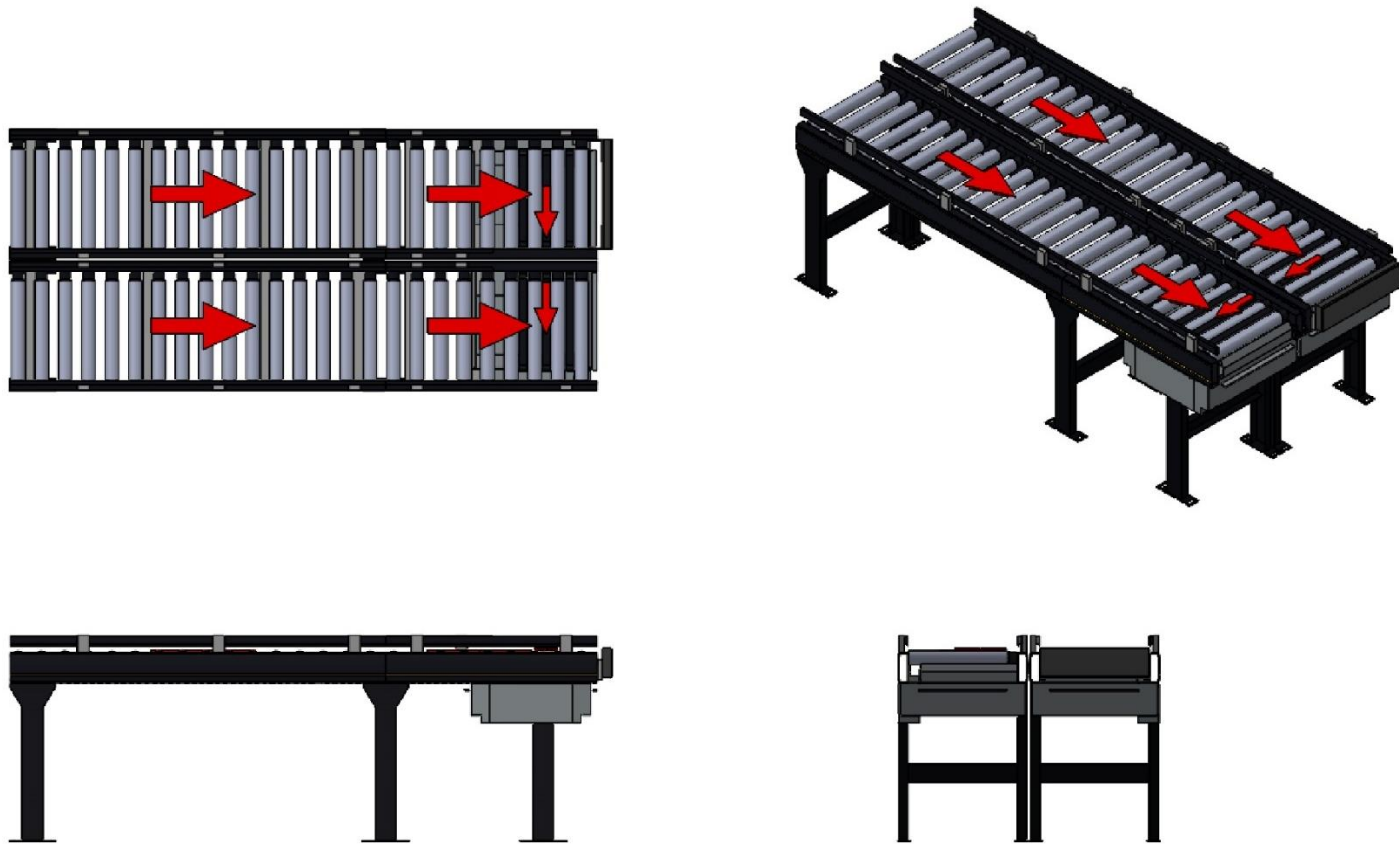

THIS DRAWING IS OUR EXCLUSIVE PROPERTY. WITHOUT OUR CONSENT THIS DRAWING MUST NOT BE REPRODUCED OR USED ELSEWHERE. WE RESERVE ALL RIGHTS ALSO IN THE CASE OF A PATENT OR REGISTERED DESIGN BEING GRANTED.

THE DESIGN AND/OR INFORMATION DEPICTED HEREON ARE THE SOLE PROPERTY OF PROCESS EVOLUTION AND MAY NOT BE COPIED IN ANY MANNER OR DISCLOSED TO ANY PERSON OR COMPANY WITHOUT OUR PRIOR PERMISSION IN WRITING.



**ProcessEvolution**  
Evolving yesterday's process for a profitable tomorrow  
[www.processrevolution.com.au](http://www.processrevolution.com.au)

EXCEPT WHERE OTHERWISE STATED  
ALL DIMENSIONS ARE IN mm  
DIMENSIONAL TOLERANCES AS  
FOLLOWS:

LINEAR:  $\pm 0.1\text{mm}$   
HOLES:  $\pm 0.1\text{mm}$   
ANGULAR:  $\pm 0.5^\circ$

REMOVE ALL BURRS & SHARP EDGES

DRAWN BY:

DATE: 15/02/2023



3RD ANGLE PROJECTION

REVISION NO:

SHEET SIZE: A3

SCALE:

DO NOT SCALE

DWG NO.: 331-210

DESCRIPTION: Large Pail Infeed Conveyors

QUANTITY:

MATERIAL:

SURFACE TREATMENT:





SHEET 1 OF 1



In-Feed Conveyor Guarding

GA Drawings

ITEM NO.	PART NUMBER	Description	Vendor	QTY.
1	Axellent - W322-190110	Panel 1900H x 1100W	Axellent	1
2	Axellent - L10-05-2 - Hitch Lock	Hitch Lock	Axellent	2
3	D10-XXX150A	Single hinge door with upper frame	Axellent	1
4	D10-XXX150A	Single hinge door with upper frame	Axellent	1
5	Axellent - P11-200	Post	Axellent	6
6	Axellent - W322-190140	Panel 1900H - 1400W	Axellent	2
7	W322-190080	Panel 1900H 800W	Axellent	2

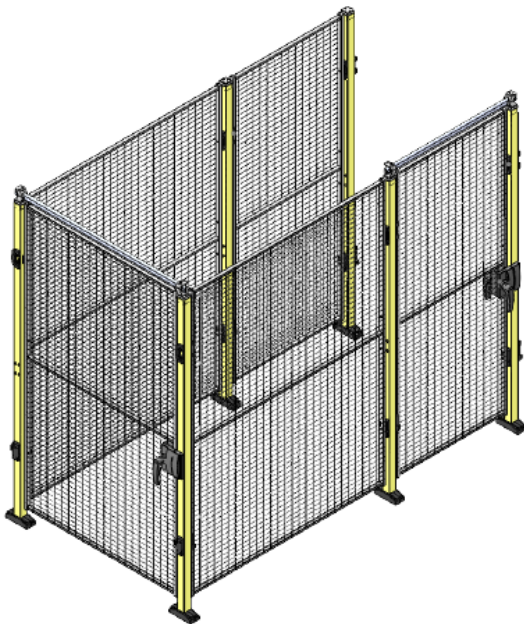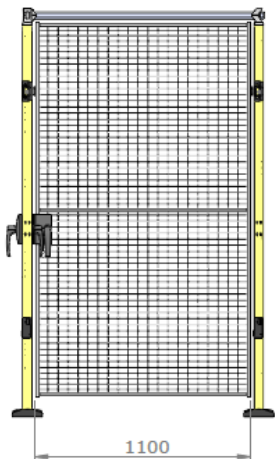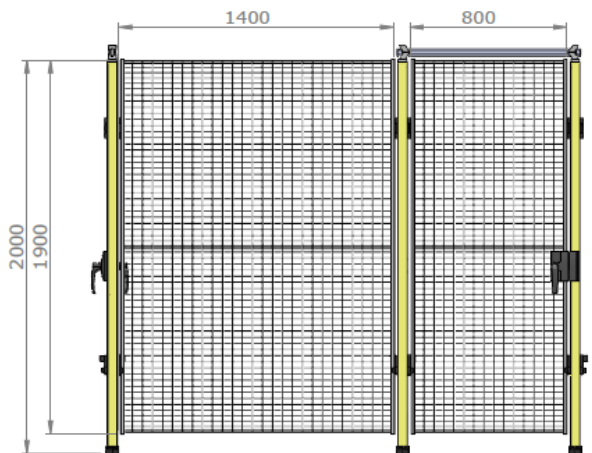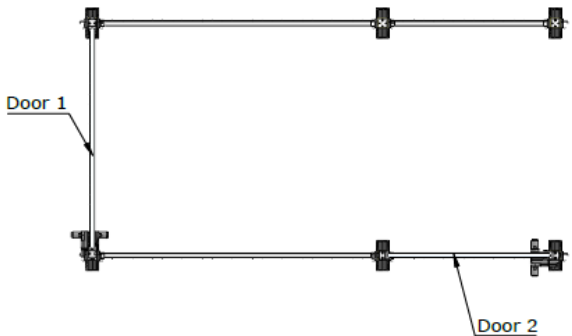

THIS DRAWING IS OUR EXCLUSIVE PROPERTY. WITHOUT OUR CONSENT THIS DRAWING MUST NOT BE REPRODUCED OR USED ELSEWHERE. WE RESERVE ALL RIGHTS ALSO IN THE CASE OF A PATENT OR REGISTERED DESIGN BEING GRANTED.

THE DESIGN AND/OR INFORMATION DEPICTED HEREON ARE THE SOLE PROPERTY OF PROCESS EVOLUTION AND MAY NOT BE COPIED IN ANY MANNER OR DISCLOSED TO ANY PERSON OR COMPANY WITHOUT OUR PRIOR PERMISSION IN WRITING.



**Process Evolution**  
Evolving yesterday's process for a profitable tomorrow  
[www.processrevolution.com.au](http://www.processrevolution.com.au)

EXCEPT WHERE OTHERWISE STATED  
ALL DIMENSIONS ARE IN mm  
DIMENSIONAL TOLERANCES AS  
FOLLOWS:

LINEAR:  $\pm 0.1\text{mm}$   
HOLES:  $\pm 0.1\text{mm}$   
ANGULAR:  $\pm 0.5^\circ$

REMOVE ALL BURRS & SHARP EDGES

DRAWN BY:

DATE: 6/12/2022



3RD ANGLE PROJECTION

REVISION NO:

SHEET SIZE: A3

SCALE:

**DO NOT SCALE**

DWG NO.: 331-230

DESCRIPTION: Safety Fencing

QUANTITY: 1

MATERIAL:

SURFACE TREATMENT:





SHEET 1 OF 1





## GA Drawings

### Denester Frame

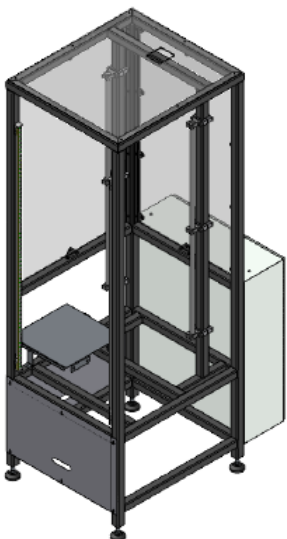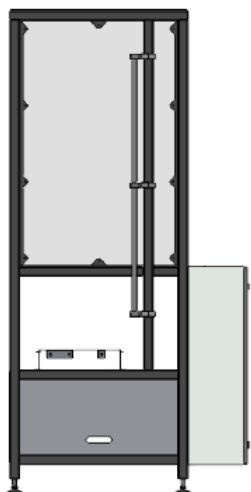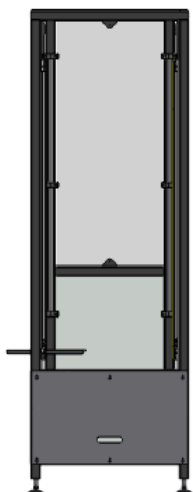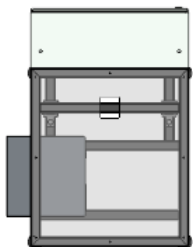

ITEM NO.	PART NUMBER	Description	Vendor	QTY.
1	331-221-02	RHS Clamp A	ProEvo - CM	6
2	331-221-03	RHS Clamp B	ProEvo - CM	6
3	331-221-01	Frame	ProEvo - Fab	1
4	331-221-08	Roof Panel	ProEvo - PR	1
5	331-221-11	LH Guard Panel	ProEvo - PR	1
6	331-221-13	Rear Guard Panel	ProEvo - PR	1
7	331-221-05	Dead Plate Mount Bracket	ProEvo - SM	2
8	331-221-06	Dead Plate	ProEvo - SM	1
9	331-221-07	Panel Mount Bracket A	ProEvo - SM	2
10	331-221-09	Lower Front Panel	ProEvo - SM	1
11	331-221-10	Lower LH Panel	ProEvo - SM	1
12	331-221-12	Panel Mount Bracket B	ProEvo - SM	2
13	331-221-14	Panel Mount Bracket C	ProEvo - SM	4
14	331-221-15	Guard Panel Washer	ProEvo - SM	20
15	SICK - C2C-SA1503XX10000	Light Curtain	Sick	2
16	331-221-04	Linear Shaft	Statewide	2
17	THK - SK25	Linear Shaft Clamp	Statewide	6
18	LVR8020100SSS	Machine Feet	Richmond Castors	4
19	AE 1180.500	Electrical Enclosure	Rittal	1

THIS DRAWING IS OUR EXCLUSIVE PROPERTY. WITHOUT OUR CONSENT THIS DRAWING MUST NOT BE REPRODUCED OR USED ELSEWHERE. WE RESERVE ALL RIGHTS ALSO IN THE CASE OF A PATENT OR REGISTERED DESIGN BEING GRANTED.

THE DESIGN AND/OR INFORMATION DEPICTED HEREON ARE THE SOLE PROPERTY OF PROCESS EVOLUTION AND MAY NOT BE COPIED IN ANY MANNER OR DISCLOSED TO ANY PERSON OR COMPANY WITHOUT OUR PRIOR PERMISSION IN WRITING.



**Process Evolution**  
Evolving yesterday's process for a profitable tomorrow  
[www.processevolution.com.au](http://www.processevolution.com.au)

EXCEPT WHERE OTHERWISE STATED  
ALL DIMENSIONS ARE IN mm  
DIMENSIONAL TOLERANCES AS  
FOLLOWS:  
LINEAR:  $\pm 0.1\text{mm}$   
HOLES:  $\pm 0.1\text{mm}$   
ANGULAR:  $\pm 0.5^\circ$   
REMOVE ALL BURRS & SHARP EDGES

DRAWN BY:

DATE: 7/12/2022



REVISION NO:

SHEET SIZE: A3

SCALE:

**DO NOT SCALE**

DWG NO.: 331-221

DESCRIPTION: Large Pail Denester Frame

QUANTITY:

MATERIAL:


SURFACE TREATMENT:

SHEET 1 OF 1

## GA Drawings

### Denester Z-Axis Servo Actuator

ITEM NO.	PART NUMBER	Description	Vendor	QTY.
1	Festo - 1586372_EAMM-U-86-D40-60H-102-S1	Parallel Kit	Festo	1
2	Festo - 2297687_EMGA-60-P-G5-EAS-60	Gearbox	Festo	1
3	Festo - 2787470_DAMS-K-V1-40-V-R3	Actuator Mount	Festo	1
4	Festo - 5242199_EMMT-AS-60-S-LS-RMB	Servo Motor	Festo	1
5	Festo - 6141_FK-M12X125	Rod End	Festo	1
6	Festo - 8022580_ESBF-BS-40-400-10P	Actuator	Festo	1
7	331-222-01	Axis Mount Bracket A	ProEvo - CM	1
8	331-222-02	Axis Mount Bracket B	ProEvo - CM	1

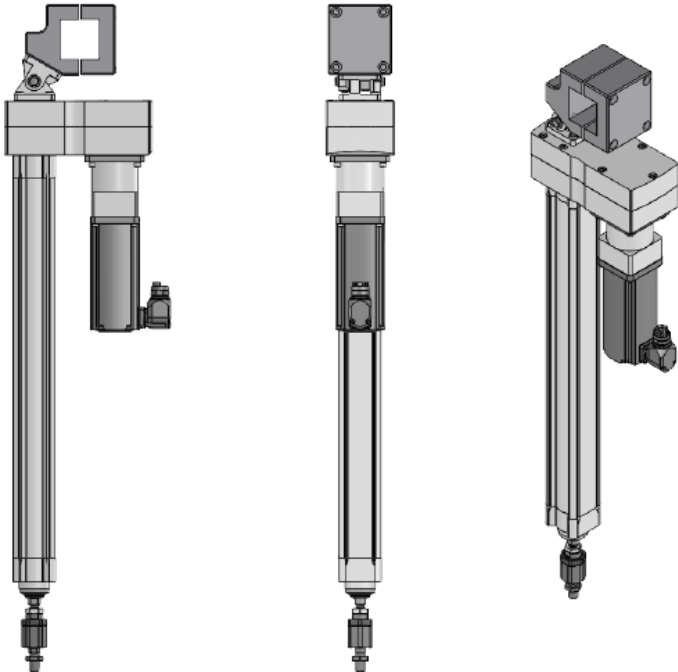

THIS DRAWING IS OUR EXCLUSIVE PROPERTY, WITHOUT OUR CONSENT THIS DRAWING MUST NOT BE REPRODUCED OR USED ELSEWHERE. WE RESERVE ALL RIGHTS ALSO IN THE CASE OF A PATENT OR REGISTERED DESIGN BEING GRANTED.

THE DESIGN AND/OR INFORMATION DEPICTED HEREON ARE THE SOLE PROPERTY OF PROCESS EVOLUTION AND MAY NOT BE COPIED IN ANY MANNER OR DISCLOSED TO ANY PERSON OR COMPANY WITHOUT OUR PRIOR PERMISSION IN WRITING.



**Process Evolution**  
Evolving yesterday's process for a profitable tomorrow  
[www.processrevolution.com.au](http://www.processrevolution.com.au)

EXCEPT WHERE OTHERWISE STATED  
ALL DIMENSIONS ARE IN mm  
DIMENSIONAL TOLERANCES AS  
FOLLOWS:  
LINEAR:  $\pm 0.1\text{mm}$   
HOLES:  $\pm 0.1\text{mm}$   
ANGULAR:  $\pm 0.5^\circ$   
REMOVE ALL BURRS & SHARP EDGES

DRAWN BY:

DATE: 7/12/2022



3RD ANGLE PROJECTION

REVISION NO:

SHEET SIZE: A3

SCALE:

DO NOT SCALE

DWG NO.: 331-222

DESCRIPTION: 331-222 - Large Pail Denester Servo Axis

QUANTITY:

MATERIAL:


SURFACE TREATMENT:

SHEET 1 OF 1



## GA Drawings

### Denester Carriage

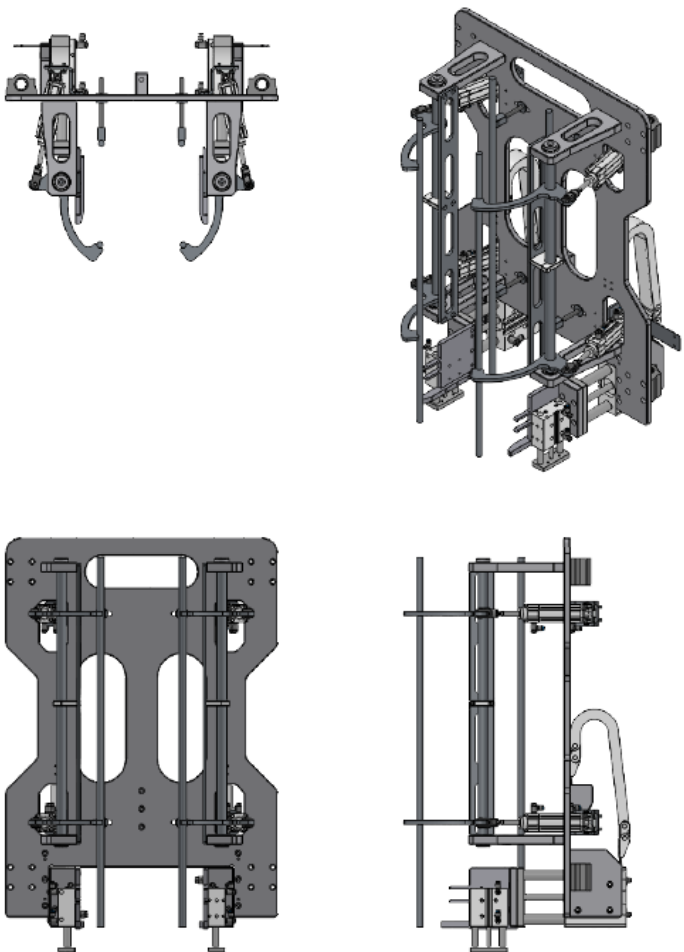

ITEM NO.	PART NUMBER	Description	Vendor	QTY.
1	331-223-05	Keeper Rod Attachment Block	ProEvo - CM	4
2	Festo - SNCB-32_174390	Actuator Mount	Festo	4
3	Festo - 1376423_DSBC-32-40-PPVA-N3	Pail Stack Cage Actuator	Festo	4
4	Festo - 170851_DFM-25-50-P-A-GF	Pail Pusher Actuator	Festo	2
5	Festo - 170874_DFM-50-100-P-A-GF	Pail Separator Actuator	Festo	2
6	Festo - 193146_GRLA-1_4-QS-6-D	Flow Control	Festo	4
7	331-223-01	Main Carriage Plate	ProEvo - CM	1
8	331-223-02	Pail Stack Support Shaft	ProEvo - CM	4
9	331-223-04	Pivot Shaft	ProEvo - CM	2
10	331-223-06	All Thread M10 L140	ProEvo - CM	4
11	331-223-07	Pivot Rod Main Support LHS	ProEvo - CM	2
12	331-223-08	Pivot Rod Main Support RHS	ProEvo - CM	2
13	331-223-09	Servo Cylinder Base - Bottom	ProEvo - CM	1
14	331-223-10	Pail Stack Primary Support Plate - Rear	ProEvo - CM	1
15	331-223-11	Pail Stack Primary Support Plate - Front	ProEvo - CM	1
16	331-223-12	Shaft Cap M8	ProEvo - CM	4
17	331-223-13	Pail Stack Alignment Guide	ProEvo - CM	2
18	331-223-14	Guide Block - Alignment Plate	ProEvo - CM	2
19	331-223-17	Pail Stack Secondary Mount	ProEvo - CM	2
20	331-223-18	Pail Stack Finger Support - LHS	ProEvo - CM	1
21	331-223-19	Pail Stack Finger Support - RHS	ProEvo - CM	1
22	331-223-20	Pail Stack Support Bar	ProEvo - CM	2
23	331-223-23	Guide Block - Alignment Plate	ProEvo - CM	2
24	331-223-03	Swing Arm	ProEvo - SM	4
25	331-223-15	Sheetmetal Cylinder Support	ProEvo - SM	4
26	331-223-16	Large Washer	ProEvo - SM	8
27	331-223-22	E Chain Mount Bracket	ProEvo - SM	2
28	Bearing - SC25UU	Linear Bearing	Statewide	4
29	CPS - 030.35.R48_B1-471L_(0_049174001271)	E Chain	Swicthes Plus	2
30	GRLA-1_8-QS-6-D	Flow Control 1/8" 6mm	Festo	12
31	SG-M10X125	Clevis M10x1.25	Festo	4
32	SNCL-32	Swivel Flange	Festo	4
33	2204 E-2RS1TN9	Self Aligning Ball Bearing I.D 20mm OD 47mm	Statewide	4

THIS DRAWING IS OUR EXCLUSIVE PROPERTY. WITHOUT OUR CONSENT THIS DRAWING MUST NOT BE REPRODUCED OR USED ELSEWHERE. WE RESERVE ALL RIGHTS ALSO IN THE CASE OF A PATENT OR REGISTERED DESIGN BEING GRANTED.

THE DESIGN AND/OR INFORMATION DEPICTED HEREON ARE THE SOLE PROPERTY OF PROCESS EVOLUTION AND MAY NOT BE COPIED IN ANY MANNER OR DISCLOSED TO ANY PERSON OR COMPANY WITHOUT OUR PRIOR PERMISSION IN WRITING.



**ProcessEvolution**  
Evolving yesterday's process for a profitable tomorrow  
[www.processevolution.com.au](http://www.processevolution.com.au)

EXCEPT WHERE OTHERWISE STATED  
ALL DIMENSIONS ARE IN mm  
DIMENSIONAL TOLERANCES AS  
FOLLOWS:

LINEAR:  $\pm 0.1\text{mm}$   
HOLES:  $\pm 0.1\text{mm}$   
ANGULAR:  $\pm 0.5^\circ$

REMOVE ALL BURRS & SHARP EDGES

DRAWN BY:

DATE: 7/12/2022

REVISION NO:

SHEET SIZE: A3

SCALE:

DO NOT SCALE

3RD ANGLE PROJECTION

DWG NO.: 331-223

DESCRIPTION: Large Pail Denester Carriage

QUANTITY: 1

MATERIAL: Material <not specified>

SURFACE TREATMENT: None

SHEET 1 OF 1






## GA Drawings

### Denester Pail Out-Feed Transfer

ITEM NO.	PART NUMBER	Description	Vendor	QTY.
1	Festo - 532448_DGC-32-800-KF-YSRW-A	DGC-32-800-KF-YSRW-A	Festo	1
2	Festo - 533669_HPC-32	HPC-32	Festo	1
3	331-224-02	Actuator Mount Bracket	ProEvo - CM	2
4	331-224-03	Pail Push Part	ProEvo - CM	1
5	331-224-05	Carriage Mount Plate	ProEvo - CM	1
6	331-224-06	Pail Pusher Gusset	ProEvo - CM	1
7	331-224-04	Assembly Mount Bracket	ProEvo - SM	2
8	331-224-01	Extrusion Mount Member	Robotunits	1
9	GRLA-1_8-QS-6-D	Flow Control 1/8" 6mm	Festo	2
10	CAP 4081	End Cap 40x80	Robot Units	2

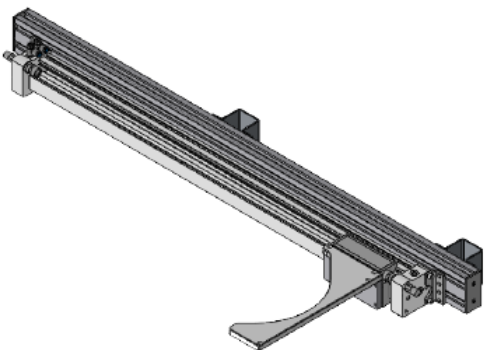

THIS DRAWING IS OUR EXCLUSIVE PROPERTY. WITHOUT OUR CONSENT THIS DRAWING MUST NOT BE REPRODUCED OR USED ELSEWHERE. WE RESERVE ALL RIGHTS ALSO IN THE CASE OF A PATENT OR REGISTERED DESIGN BEING GRANTED.

THE DESIGN AND/OR INFORMATION DEPICTED HEREON ARE THE SOLE PROPERTY OF PROCESS EVOLUTION AND MAY NOT BE COPIED IN ANY MANNER OR DISCLOSED TO ANY PERSON OR COMPANY WITHOUT OUR PRIOR PERMISSION IN WRITING.



**Process Evolution**  
Evolving yesterday's process for a profitable tomorrow  
[www.processrevolution.com.au](http://www.processrevolution.com.au)

EXCEPT WHERE OTHERWISE STATED  
ALL DIMENSIONS ARE IN mm  
DIMENSIONAL TOLERANCES AS  
FOLLOWS:  
LINEAR:  $\pm 0.1\text{mm}$   
HOLES:  $\pm 0.1\text{mm}$   
ANGULAR:  $\pm 0.5^\circ$   
REMOVE ALL BURRS & SHARP EDGES

DRAWN BY:

DATE: 7/12/2022



3RD ANGLE PROJECTION

REVISION NO:

SHEET SIZE: A3

SCALE:

**DO NOT SCALE**

DWG NO.: 331-224

DESCRIPTION: Large Pail Transfer Pusher

QUANTITY:

MATERIAL:

SURFACE TREATMENT:





SHEET 1 OF 1



## GA Drawings

### Denester Vacuum Plate

ITEM NO.	PART NUMBER	Description	Vendor	QTY.
1	Festo - DFM-40-50-P-A-GF_170865	Actuator	Festo	1
2	Festo - ESS-40-BU	Suction Cup	Festo	2
3	331-225-01	Pail De-Nest Centre Plate	ProEvo - CM	1
4	331-225-02	SUCTION ASSY ANCHOR BRACKET	ProEvo - CM	2
5	331-225-05	Pail Hold Pin	ProEvo - CM	2
6	331-225-06	Standoff - Vacuum Cups	ProEvo - CM	6
7	331-225-03	STACK VACUUM PLATE - BOTTOM	ProEvo - SM	1
8	331-225-04	STACK VACUUM PLATE - TOP	ProEvo - SM	1
9	GRLA-1_8-QS-6-D	Flow Control 1/8" 6mm	Festo	2

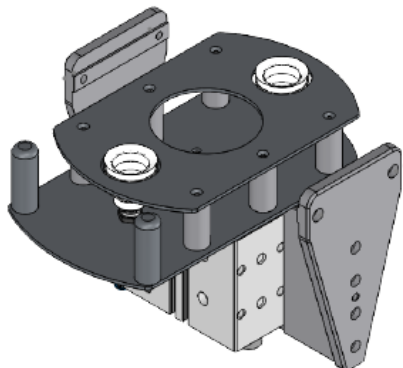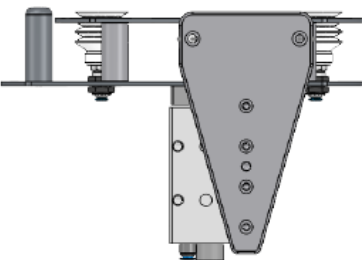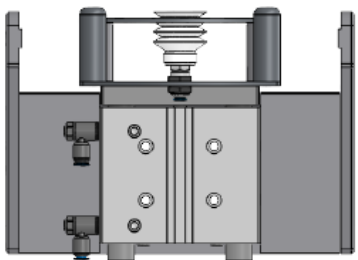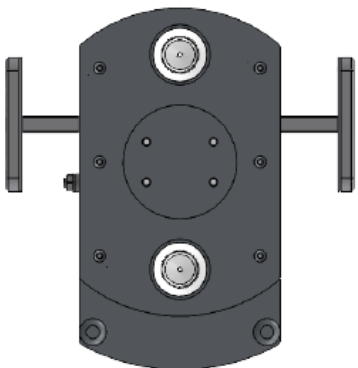

THIS DRAWING IS OUR EXCLUSIVE PROPERTY. WITHOUT OUR CONSENT THIS DRAWING MUST NOT BE REPRODUCED OR USED ELSEWHERE. WE RESERVE ALL RIGHTS ALSO IN THE CASE OF A PATENT OR REGISTERED DESIGN BEING GRANTED.

THE DESIGN AND/OR INFORMATION DEPICTED HEREON ARE THE SOLE PROPERTY OF PROCESS EVOLUTION AND MAY NOT BE COPIED IN ANY MANNER OR DISCLOSED TO ANY PERSON OR COMPANY WITHOUT OUR PRIOR PERMISSION IN WRITING.



**Process Evolution**  
Evolving yesterday's process for a profitable tomorrow  
[www.processevolution.com.au](http://www.processevolution.com.au)

EXCEPT WHERE OTHERWISE STATED  
ALL DIMENSIONS ARE IN mm  
DIMENSIONAL TOLERANCES AS  
FOLLOWS:  
LINEAR:  $\pm 0.1\text{mm}$   
HOLES:  $\pm 0.1\text{mm}$   
ANGULAR:  $\pm 0.5^\circ$   
REMOVE ALL BURRS & SHARP EDGES

DRAWN BY:

DATE: 7/12/2022



3RD ANGLE PROJECTION

REVISION NO:

SHEET SIZE: A3

SCALE:

DO NOT SCALE

DWG NO.: 331-225

DESCRIPTION: Large Pail Vac Picker

QUANTITY: 1

MATERIAL: Material <not specified>


SURFACE TREATMENT: None

SHEET 1 OF 1



GA Drawings


Denester In-Feed Conveyor

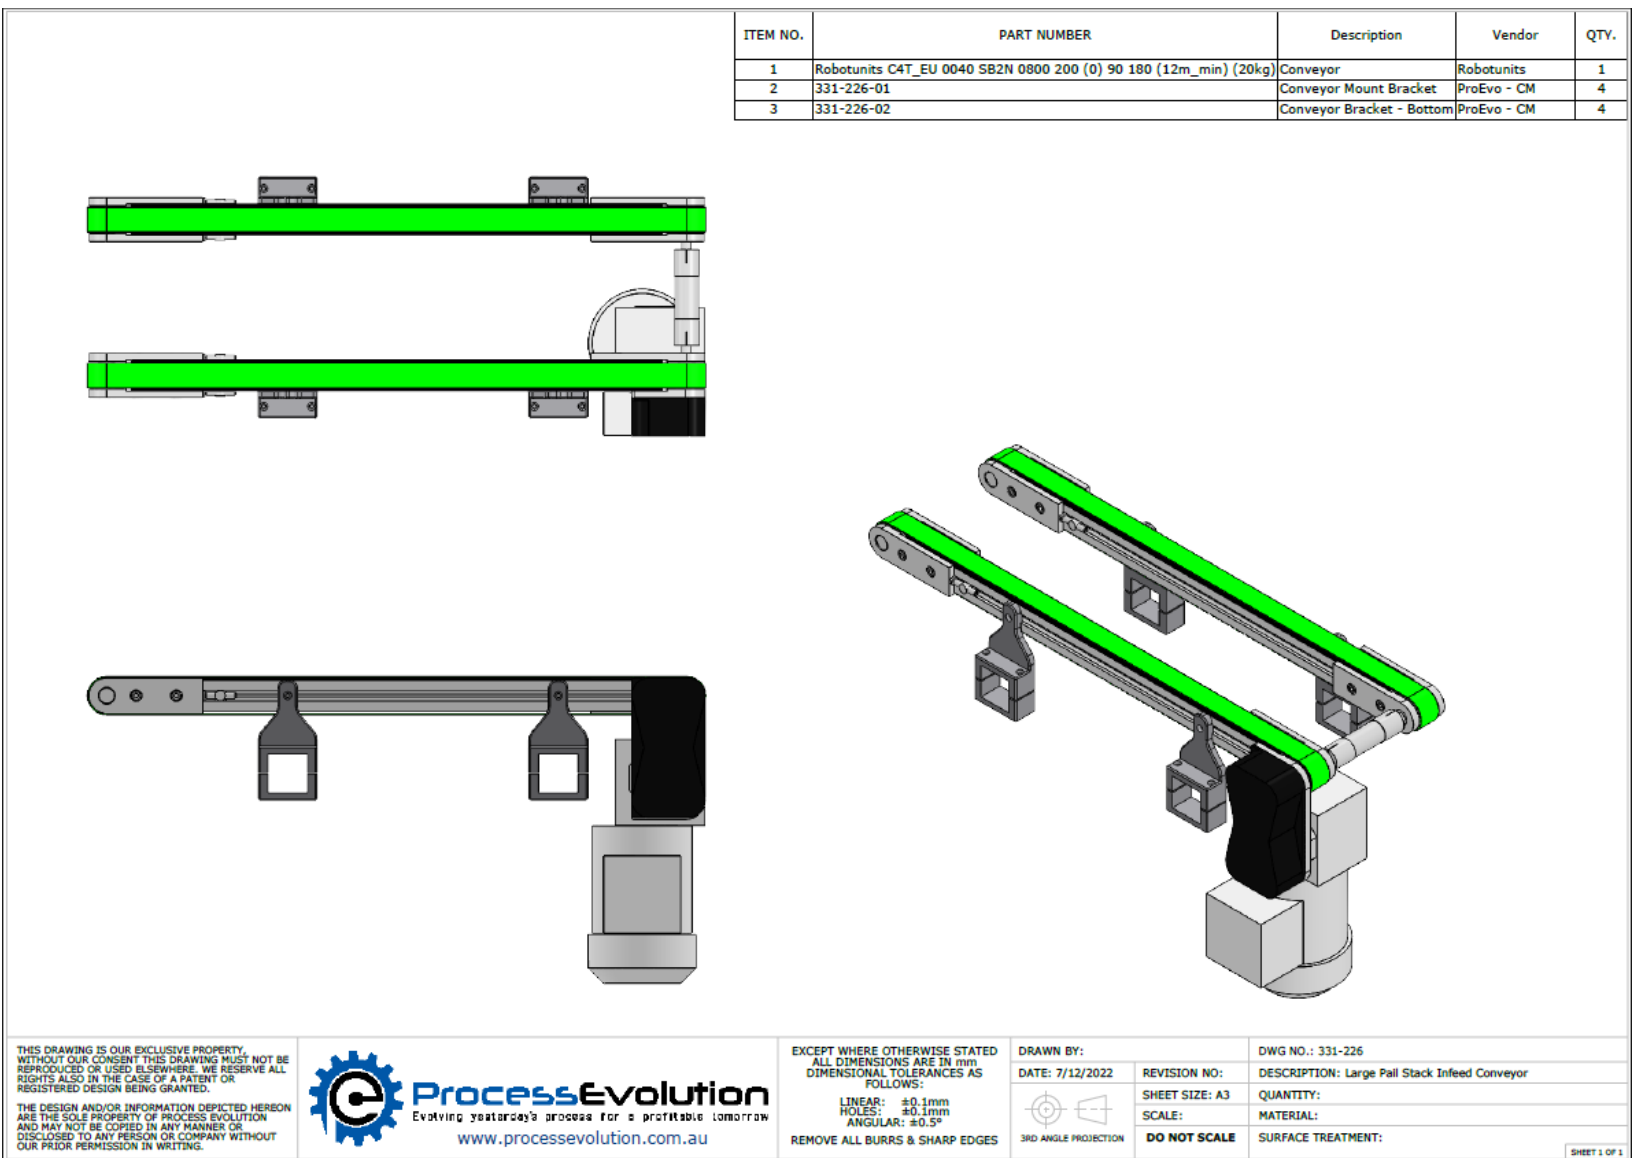



## GA Drawings

### Denester Guard Door

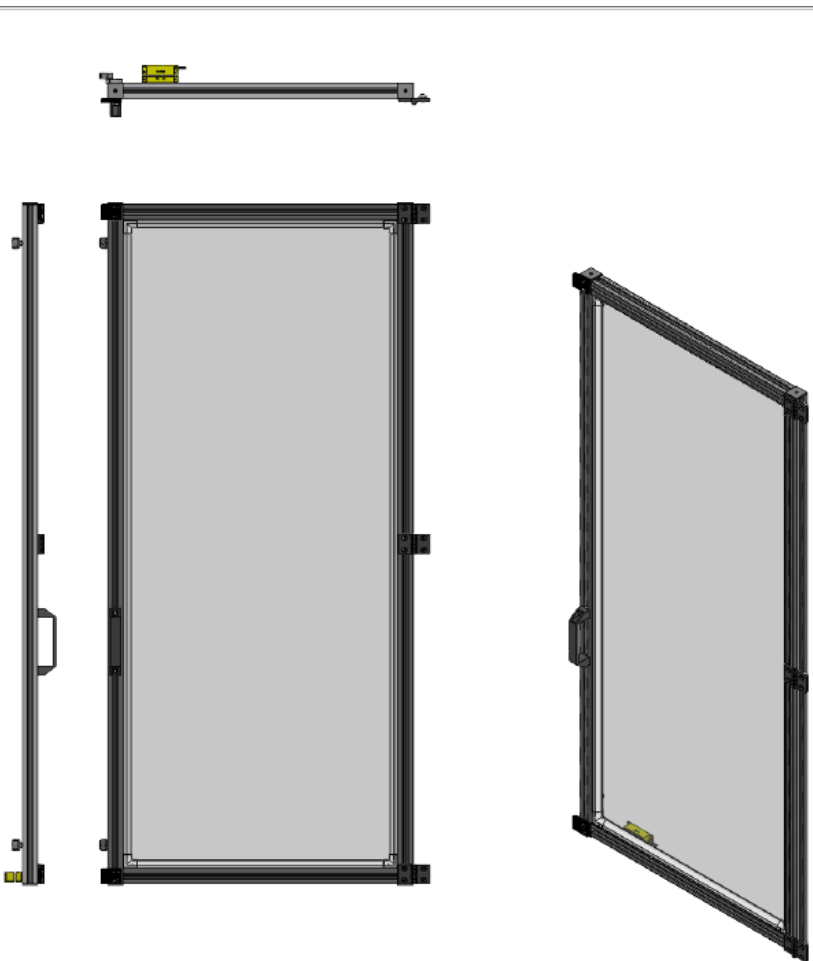

ITEM NO.	PART NUMBER	Description	Vendor	QTY.
1	331-227-04	Ball Latch Mount	ProEvo - CM	2
2	331-227-02	Polycarb Panel	ProEvo - PR	1
3	331-227-01	Door Frame	Robotunits	1
4	331-227-03	Panel Mount Trim	Robotunits	1
5	AMX5-MKT_BTI Comtronics	Safety Switch - Non Contact	Balluff	1
6	BPS.30	Ball-shaped door lock	Elesa & Ganter	2
7	CAN 4501	Corner Piece	Robotunits	4
8	CAP 4041	End Cap	Robotunits	4
9	DOR 4501	Handle	Robotunits	1
10	DOR 4511	Hinge	Robotunits	3
11	DOR 4555	Door Stop	Robotunits	2

THIS DRAWING IS OUR EXCLUSIVE PROPERTY. WITHOUT OUR CONSENT THIS DRAWING MUST NOT BE REPRODUCED OR USED ELSEWHERE. WE RESERVE ALL RIGHTS ALSO IN THE CASE OF A PATENT OR REGISTERED DESIGN BEING GRANTED.

THE DESIGN AND/OR INFORMATION DEPICTED HEREON ARE THE SOLE PROPERTY OF PROCESS EVOLUTION AND MAY NOT BE COPIED IN ANY MANNER OR DISCLOSED TO ANY PERSON OR COMPANY WITHOUT OUR PRIOR PERMISSION IN WRITING.



**Process Evolution**  
Evolving yesterday's process for a profitable tomorrow  
[www.processevolution.com.au](http://www.processevolution.com.au)

EXCEPT WHERE OTHERWISE STATED  
ALL DIMENSIONS ARE IN mm  
DIMENSIONAL TOLERANCES AS  
FOLLOWS:

LINEAR:  $\pm 0.1\text{mm}$   
HOLES:  $\pm 0.1\text{mm}$   
ANGULAR:  $\pm 0.5^\circ$

REMOVE ALL BURRS & SHARP EDGES

DRAWN BY:

DATE: 7/12/2022



3RD ANGLE PROJECTION

REVISION NO:

SHEET SIZE: A3

SCALE:

**DO NOT SCALE**

DWG NO.: 331-227

DESCRIPTION: Large Pall Denester Guard Door

QUANTITY:

MATERIAL:

SURFACE TREATMENT:




SHEET 1 OF 1



## GA Drawings

### Denester Tunnel Guard

ITEM NO.	PART NUMBER	Description	Vendor	QTY.
1	331-228-03	Polycarb Top Panel	ProEvo - PR	1
2	331-228-06	Polycarb Side Panel	ProEvo - PR	2
3	331-228-01	Frame	Robotunits	1
4	331-228-02	Polycarb Trim	Robotunits	1
5	331-228-04	Polycarb Trim	Robotunits	1
6	331-228-05	Polycarb Trim	Robotunits	1
7	CAN 4501	Corner Piece	Robotunits	6
8	CAP 4041	End Cap	Robotunits	4
9	GUS 1101	Corner Bracket 100	Robotunits	4

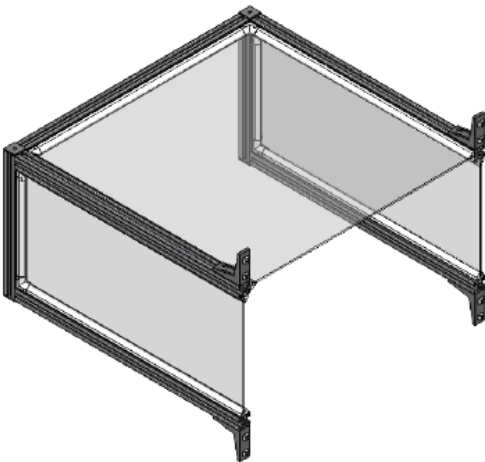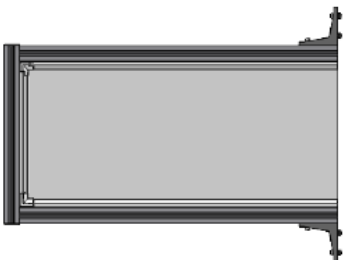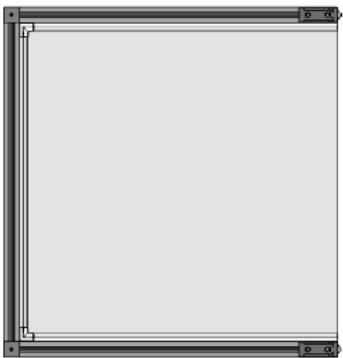

THIS DRAWING IS OUR EXCLUSIVE PROPERTY. WITHOUT OUR CONSENT THIS DRAWING MUST NOT BE REPRODUCED OR USED ELSEWHERE. WE RESERVE ALL RIGHTS ALSO IN THE CASE OF A PATENT OR REGISTERED DESIGN BEING GRANTED.

THE DESIGN AND/OR INFORMATION DEPICTED HEREON ARE THE SOLE PROPERTY OF PROCESS EVOLUTION AND MAY NOT BE COPIED IN ANY MANNER OR DISCLOSED TO ANY PERSON OR COMPANY WITHOUT OUR PRIOR PERMISSION IN WRITING.



**Process Evolution**  
Evolving yesterday's process for a profitable tomorrow  
[www.processrevolution.com.au](http://www.processrevolution.com.au)


EXCEPT WHERE OTHERWISE STATED  
ALL DIMENSIONS ARE IN mm  
DIMENSIONAL TOLERANCES AS  
FOLLOWS:

LINEAR:  $\pm 0.1\text{mm}$   
HOLES:  $\pm 0.1\text{mm}$   
ANGULAR:  $\pm 0.5^\circ$

REMOVE ALL BURRS & SHARP EDGES

DRAWN BY:

DATE: 7/12/2022

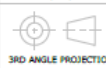

REVISION NO:

SHEET SIZE: A3

SCALE:

**DO NOT SCALE**

DWG NO.: 331-228

DESCRIPTION: Large Pail Denester Tunnel Guard

QUANTITY:

MATERIAL:


SURFACE TREATMENT:

SHEET 1 OF 1




# GA Drawings

## Denester Pneumatic Control Panel

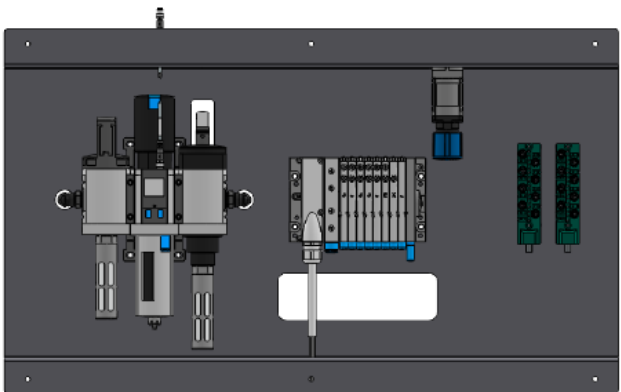

ITEM NO.	PART NUMBER	Description	Vendor	QTY.
1	Festo - 569926 34P-MS1-U8A-SJEXL	Valve Bank	Festo	1
2	331-229-01	Pneumatic Panel	ProEvo - SM	1
3	MSB6-3_8_C4_113_D4-WP	Air Service Unit	Festo	1
4	KMEB-1-24-S-LED	Plug & Cable	Festo	1
5	MS4-LR-1_4-D6-AG-MPA-B	Regulator	Festo	1
6	NEBU-M8G3-K-5-M8G3	Cable M8 3-pin 5m	Festo	1
7	QSL-G3_8-10	Push-In L G3/8" 10mm	Festo	2
8	VMPAL-KM-V-SD25-IP67-5	Connecting Cable - Valve Bank	Festo	1
9	V3-8A-E2-5M-PUR	Splitter Box 8 Way M8 3pin	Pepperl Fuchs	2

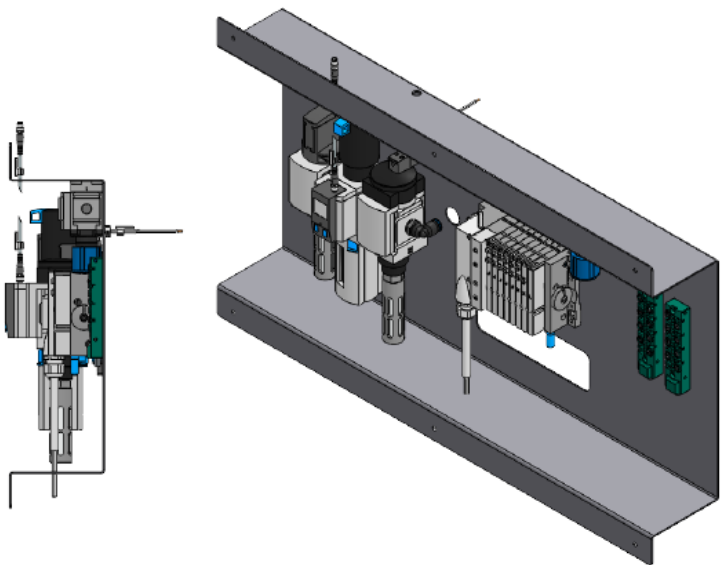

THIS DRAWING IS OUR EXCLUSIVE PROPERTY. WITHOUT OUR CONSENT THIS DRAWING MUST NOT BE REPRODUCED OR USED ELSEWHERE. WE RESERVE ALL RIGHTS ALSO IN THE CASE OF A PATENT OR REGISTERED DESIGN BEING GRANTED.

THE DESIGN AND/OR INFORMATION DEPICTED HEREON ARE THE SOLE PROPERTY OF PROCESS EVOLUTION AND MAY NOT BE COPIED IN ANY MANNER OR DISCLOSED TO ANY PERSON OR COMPANY WITHOUT OUR PRIOR PERMISSION IN WRITING.



**ProcessEvolution**  
Evolving yesterday's process for a profitable tomorrow  
[www.processevolution.com.au](http://www.processevolution.com.au)


EXCEPT WHERE OTHERWISE STATED  
ALL DIMENSIONS ARE IN mm  
DIMENSIONAL TOLERANCES AS  
FOLLOWS:

LINEAR:  $\pm 0.1\text{mm}$   
HOLES:  $\pm 0.1\text{mm}$   
ANGULAR:  $\pm 0.5^\circ$

REMOVE ALL BURRS & SHARP EDGES

DRAWN BY:

DATE: 7/12/2022

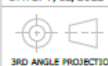

REVISION NO:

SHEET SIZE: A3

SCALE:

**DO NOT SCALE**

DWG NO.: 331-229

DESCRIPTION: Large Pall Denester Pneumatics Panel

QUANTITY:

MATERIAL:


 
SURFACE TREATMENT:

SHEET 1 OF 1








# LARGE PAIL DENESTER ELECTRICAL DRAWINGS


				CLIENT				PROJECT				REV	A				
								CSR - LARGE PAIL DENESTER				SHEET					
								TITLE PAGE				000					
A	AS BUILT		10-Feb-23	SH	MCC	<div>© COPYRIGHT RESERVED</div> <div>This drawing is the sole property of iMade Systems Pty Ltd and is to be treated as confidential &amp; is not to be copied without written approval.</div>	<div>DRAWN BY</div> <div>S.Henkul</div>	<div>FOLDER</div> <div>\Schematics\Process Evolution</div>	<div> iMade Systems Pty Ltd</div> <div>29 Woodside Drive Rowville, VIC. 3178 email: info@imade.com.au</div>				DRAWING				
REV.	DESCRIPTION		DATE	NAME	401197												



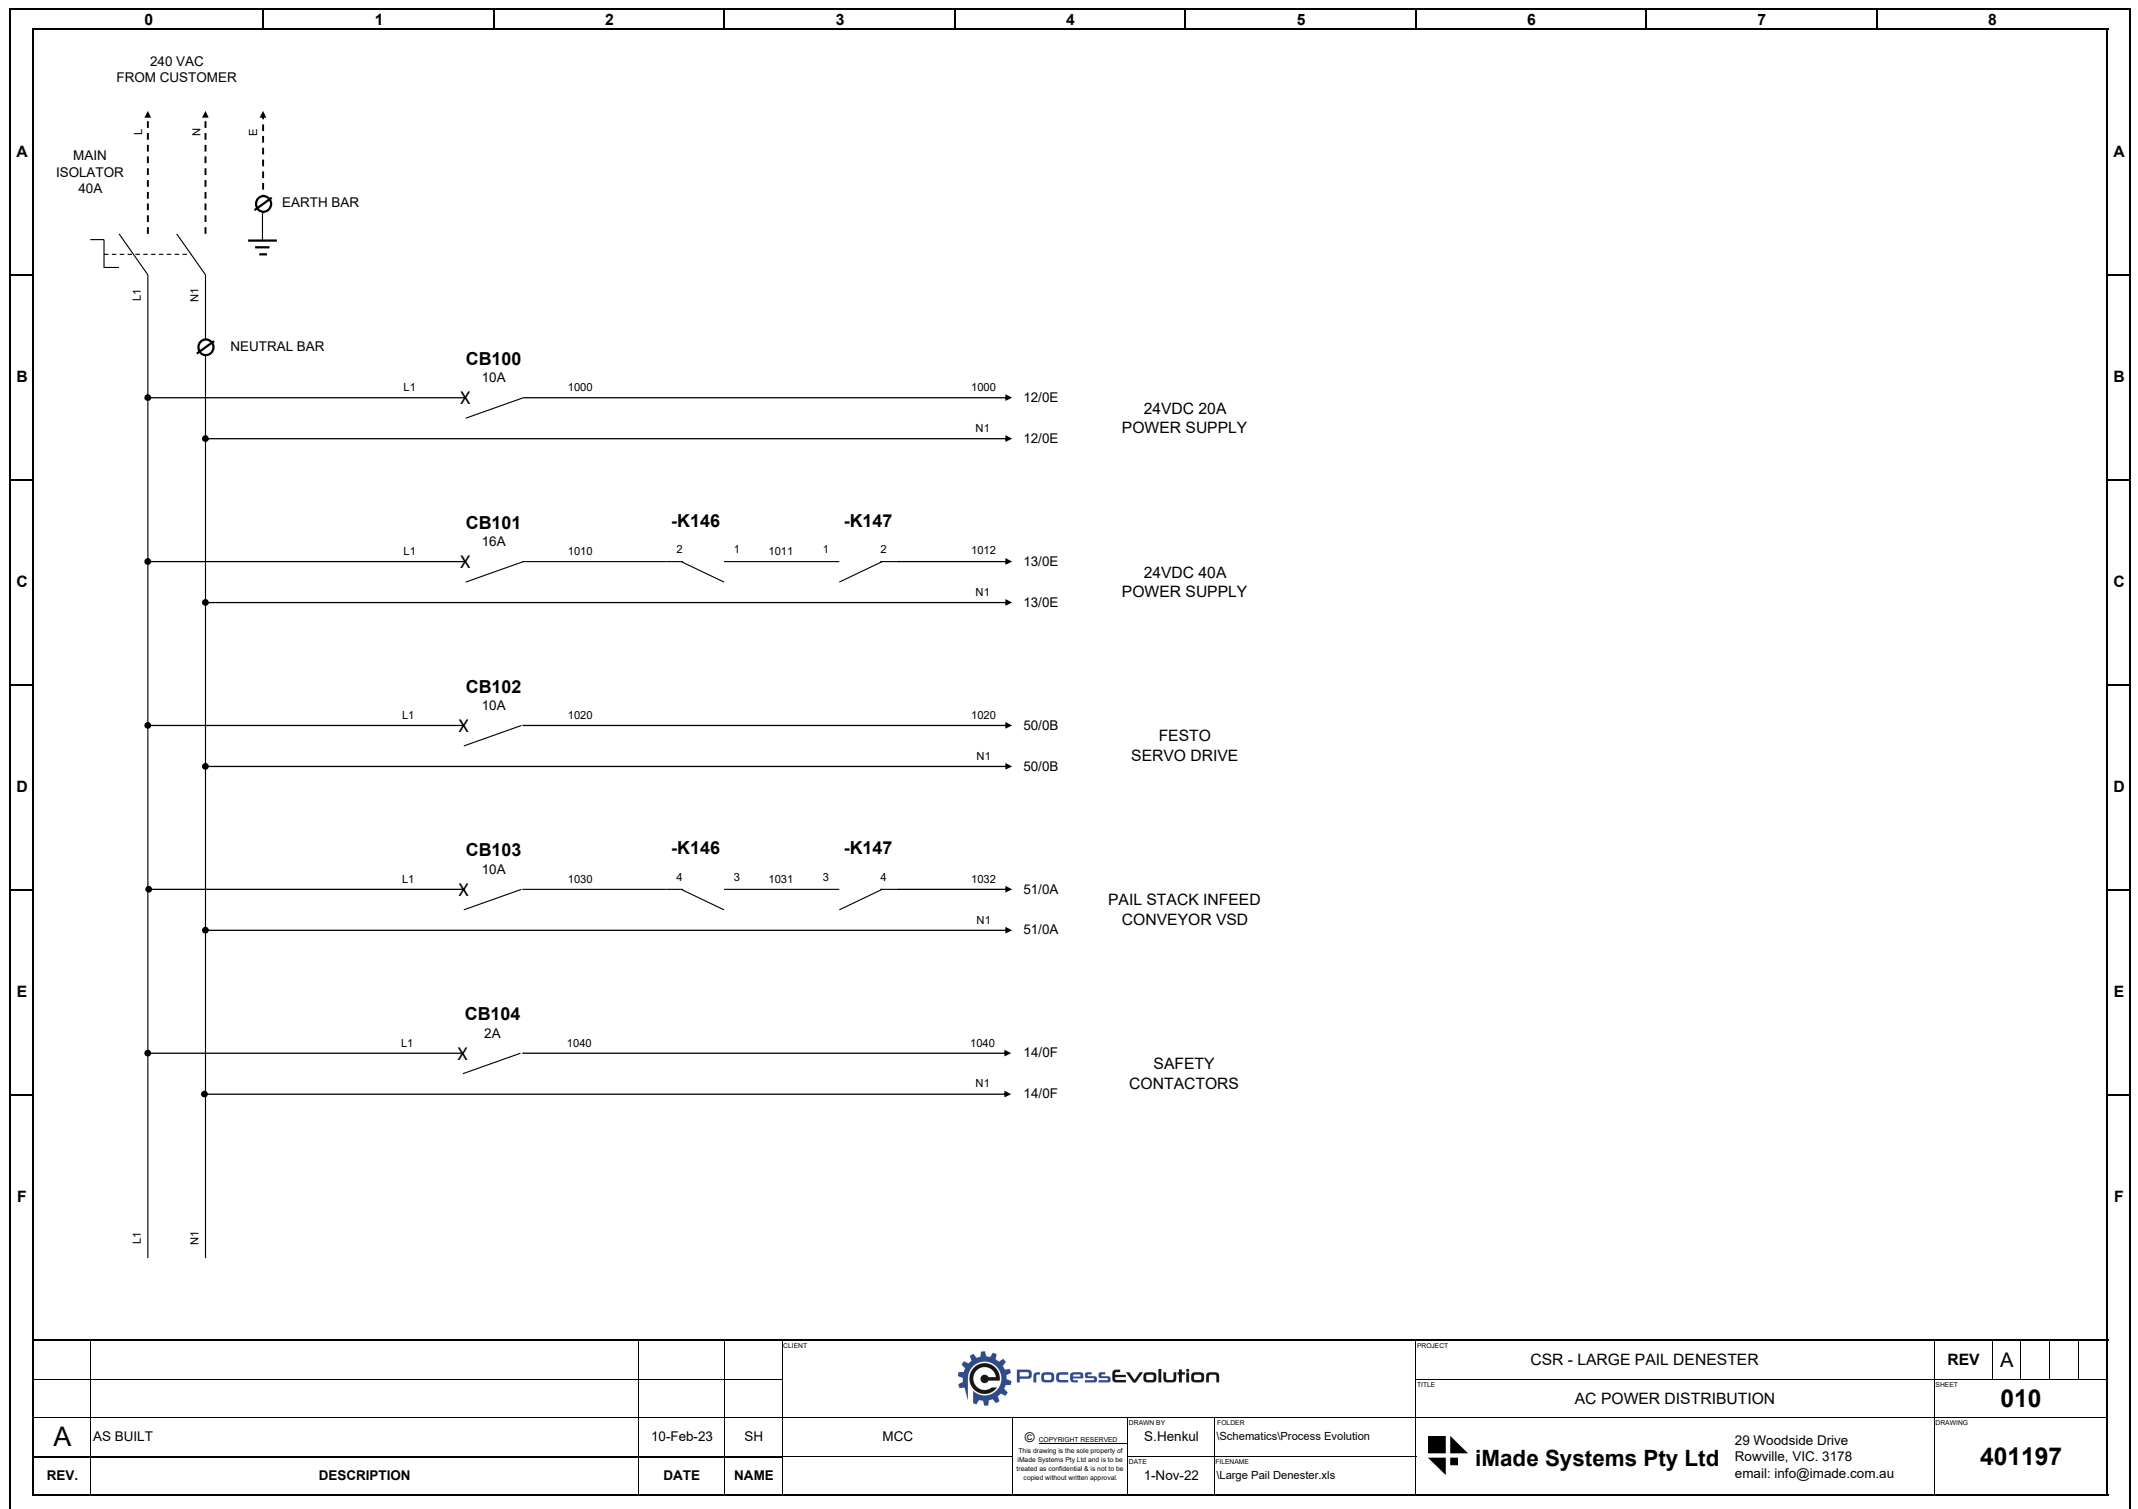





 


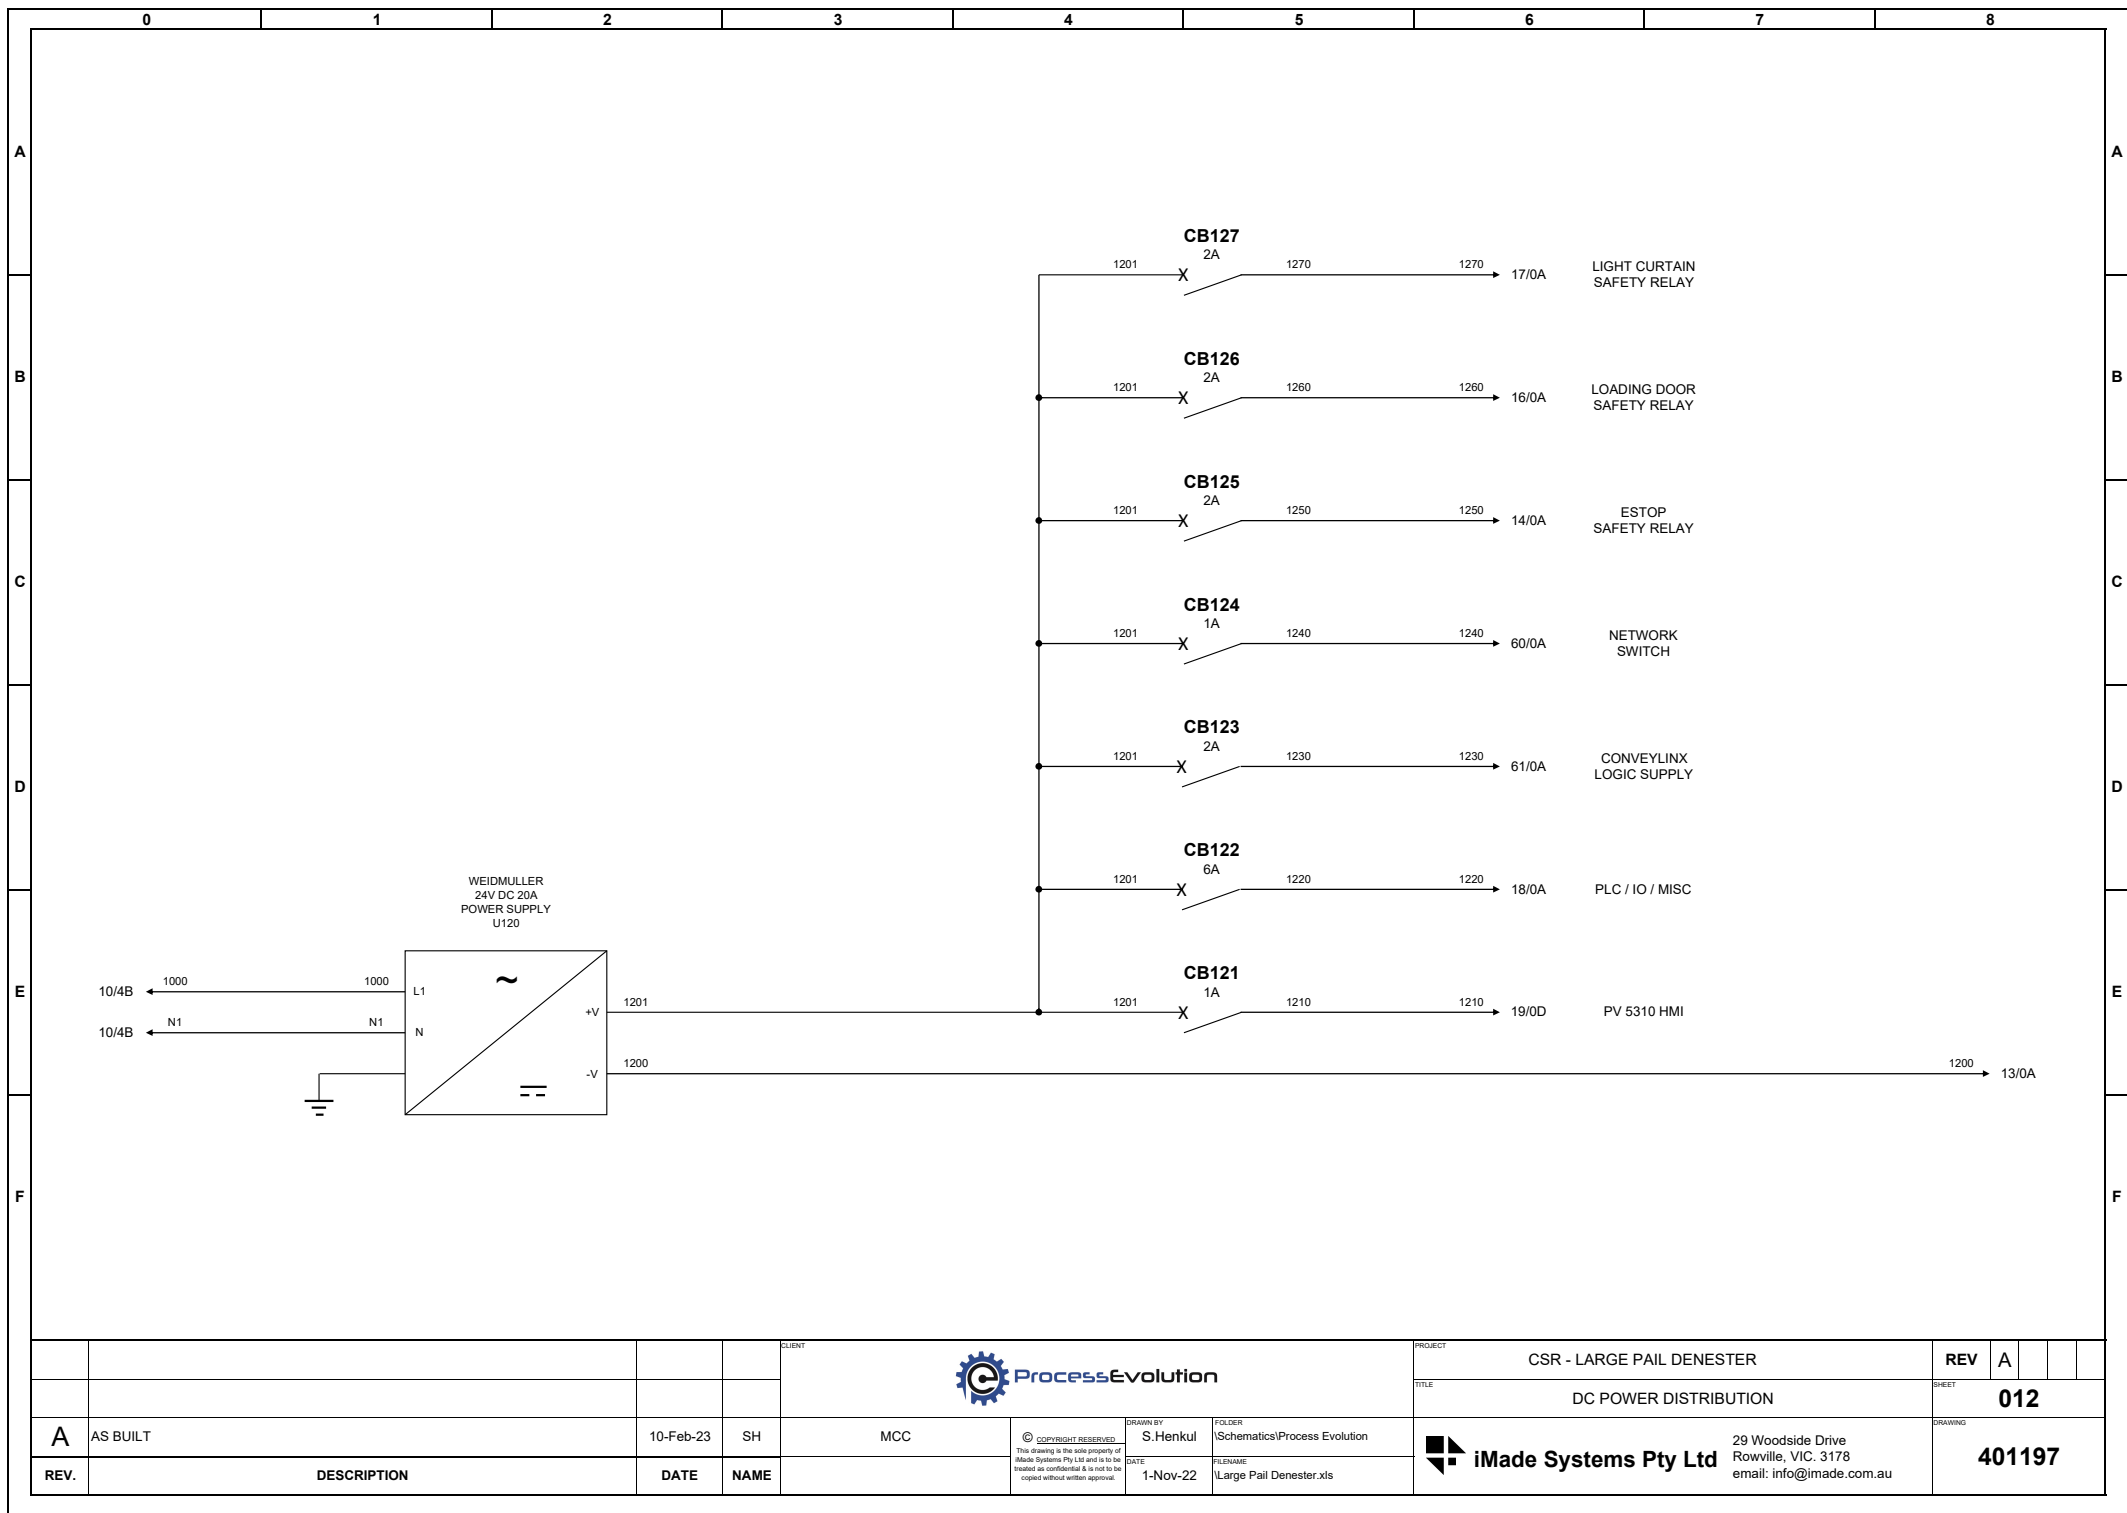			<div>CLIENT</div>				<div>PROJECT</div>			CSR - LARGE PAIL DENESTER			REV	A						
			<div><div></div><div>ProcessEvolution</div></div>							TITLE			AC POWER DISTRIBUTION			SHEET	010			
A	AS BUILT		10-Feb-23		SH	MCC	<div><div>© COPYRIGHT RESERVED</div><div>This drawing is the sole property of iMade Systems Pty Ltd and is to be treated as confidential &amp; is not to be copied without written approval.</div></div>	DRAWN BY S.Henkul	FOLDER ISchematics/Process Evolution		<div><div></div><div>iMade Systems Pty Ltd</div></div> <div>29 Woodside Drive Rowville, VIC. 3178 email: info@imade.com.au</div>			DRAWING  401197						
REV.	DESCRIPTION		DATE		NAME		DATE 1-Nov-22	FILENAME Large Pail Denester.xls												




				<div>CLIENT</div> <div></div>				<div>PROJECT</div> <div>CSR - LARGE PAIL DENESTER</div>				REV	A				
								<div>TITLE</div> <div>DC POWER DISTRIBUTION</div>				<div>SHEET</div> <div>012</div>					
A	AS BUILT			10-Feb-23	SH	MCC	<div><div>© COPYRIGHT RESERVED</div><div>This drawing is the sole property of Made Systems Pty Ltd and is to be treated as confidential &amp; is not to be copied without written approval.</div></div>	<div>DRAWN BY</div> <div>S.Henkul</div>	<div>FOLDER</div> <div>I:Schematics/Process Evolution</div>	<div> iMade Systems Pty Ltd</div> <div>29 Woodside Drive Rowville, VIC. 3178 email: info@imade.com.au</div>				<div>DRAWING</div> <div>401197</div>			
REV.	DESCRIPTION				DATE	NAME											

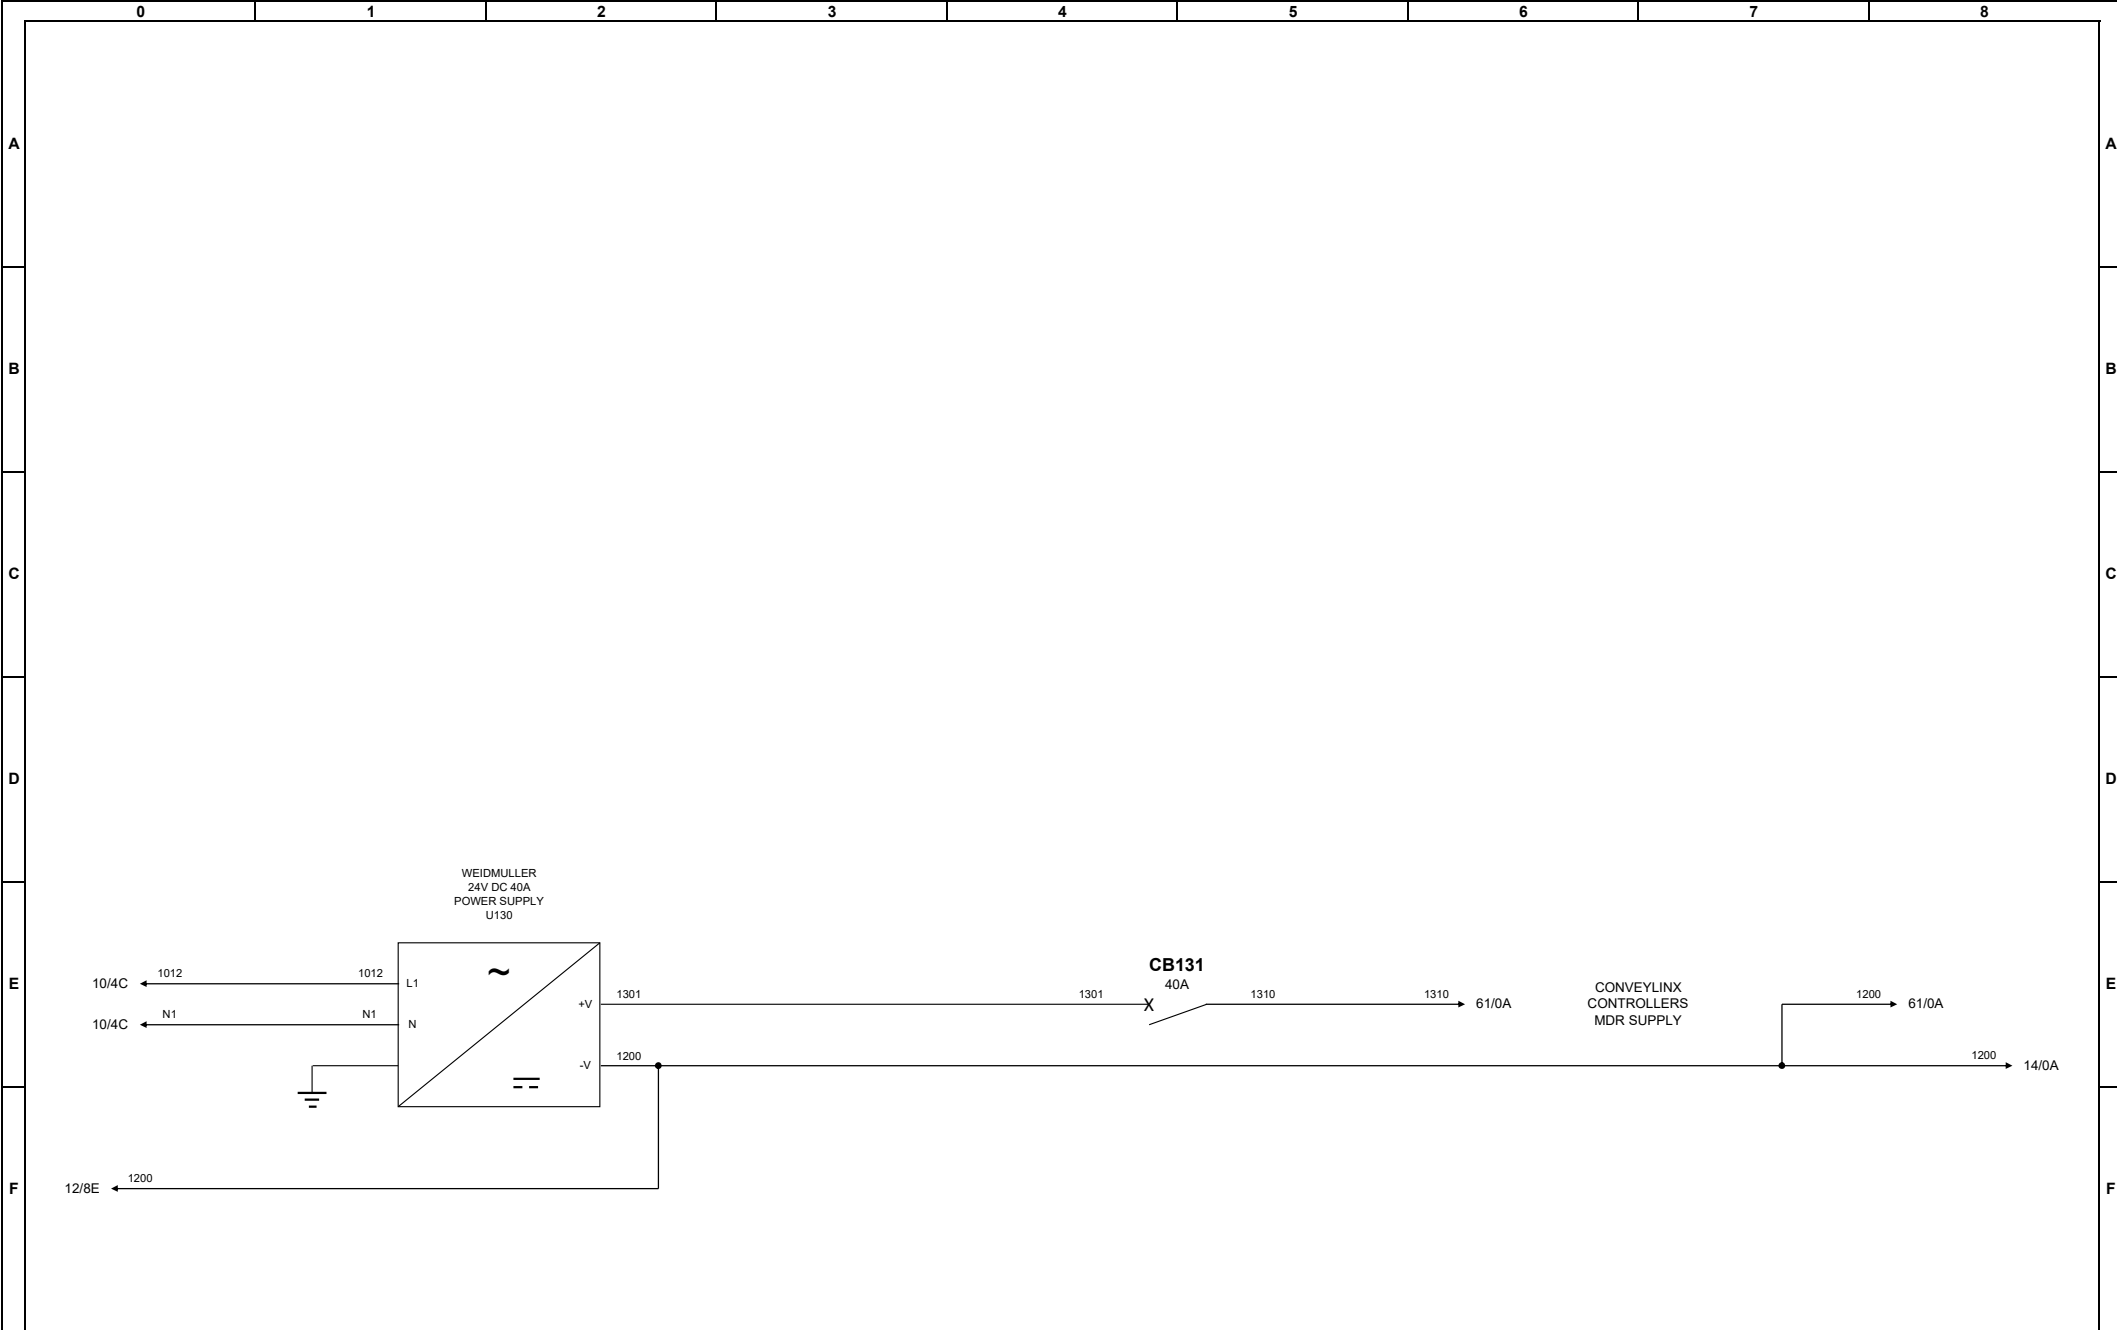

				<div>CLIENT</div> <div></div>				<div>PROJECT</div> <div>CSR - LARGE PAIL DENESTER</div>				REV	A			
								<div>TITLE</div> <div>CONVEYLINK MDR POWER DISTRIBUTION</div>				<div>SHEET</div> <div>013</div>				
A	AS BUILT			10-Feb-23	SH	MCC1	<div><div>© COPYRIGHT RESERVED</div><div>This drawing is the sole property of iMade Systems Pty Ltd and is to be treated as confidential &amp; is not to be copied without written approval.</div></div>	<div>DRAWN BY</div> <div>S.Henkul</div>	<div>FOLDER</div> <div>Schematics\Process Evolution</div>			<div> <b>iMade Systems Pty Ltd</b> 29 Woodside Drive Rowville, VIC. 3178 email: info@imade.com.au</div>				
REV.	DESCRIPTION			DATE	NAME		<div>DATE</div> <div>1-Nov-22</div>	<div>FILENAME</div> <div>Large Pail Denester.xls</div>	<div>DRAWING</div> <div>401197</div>							






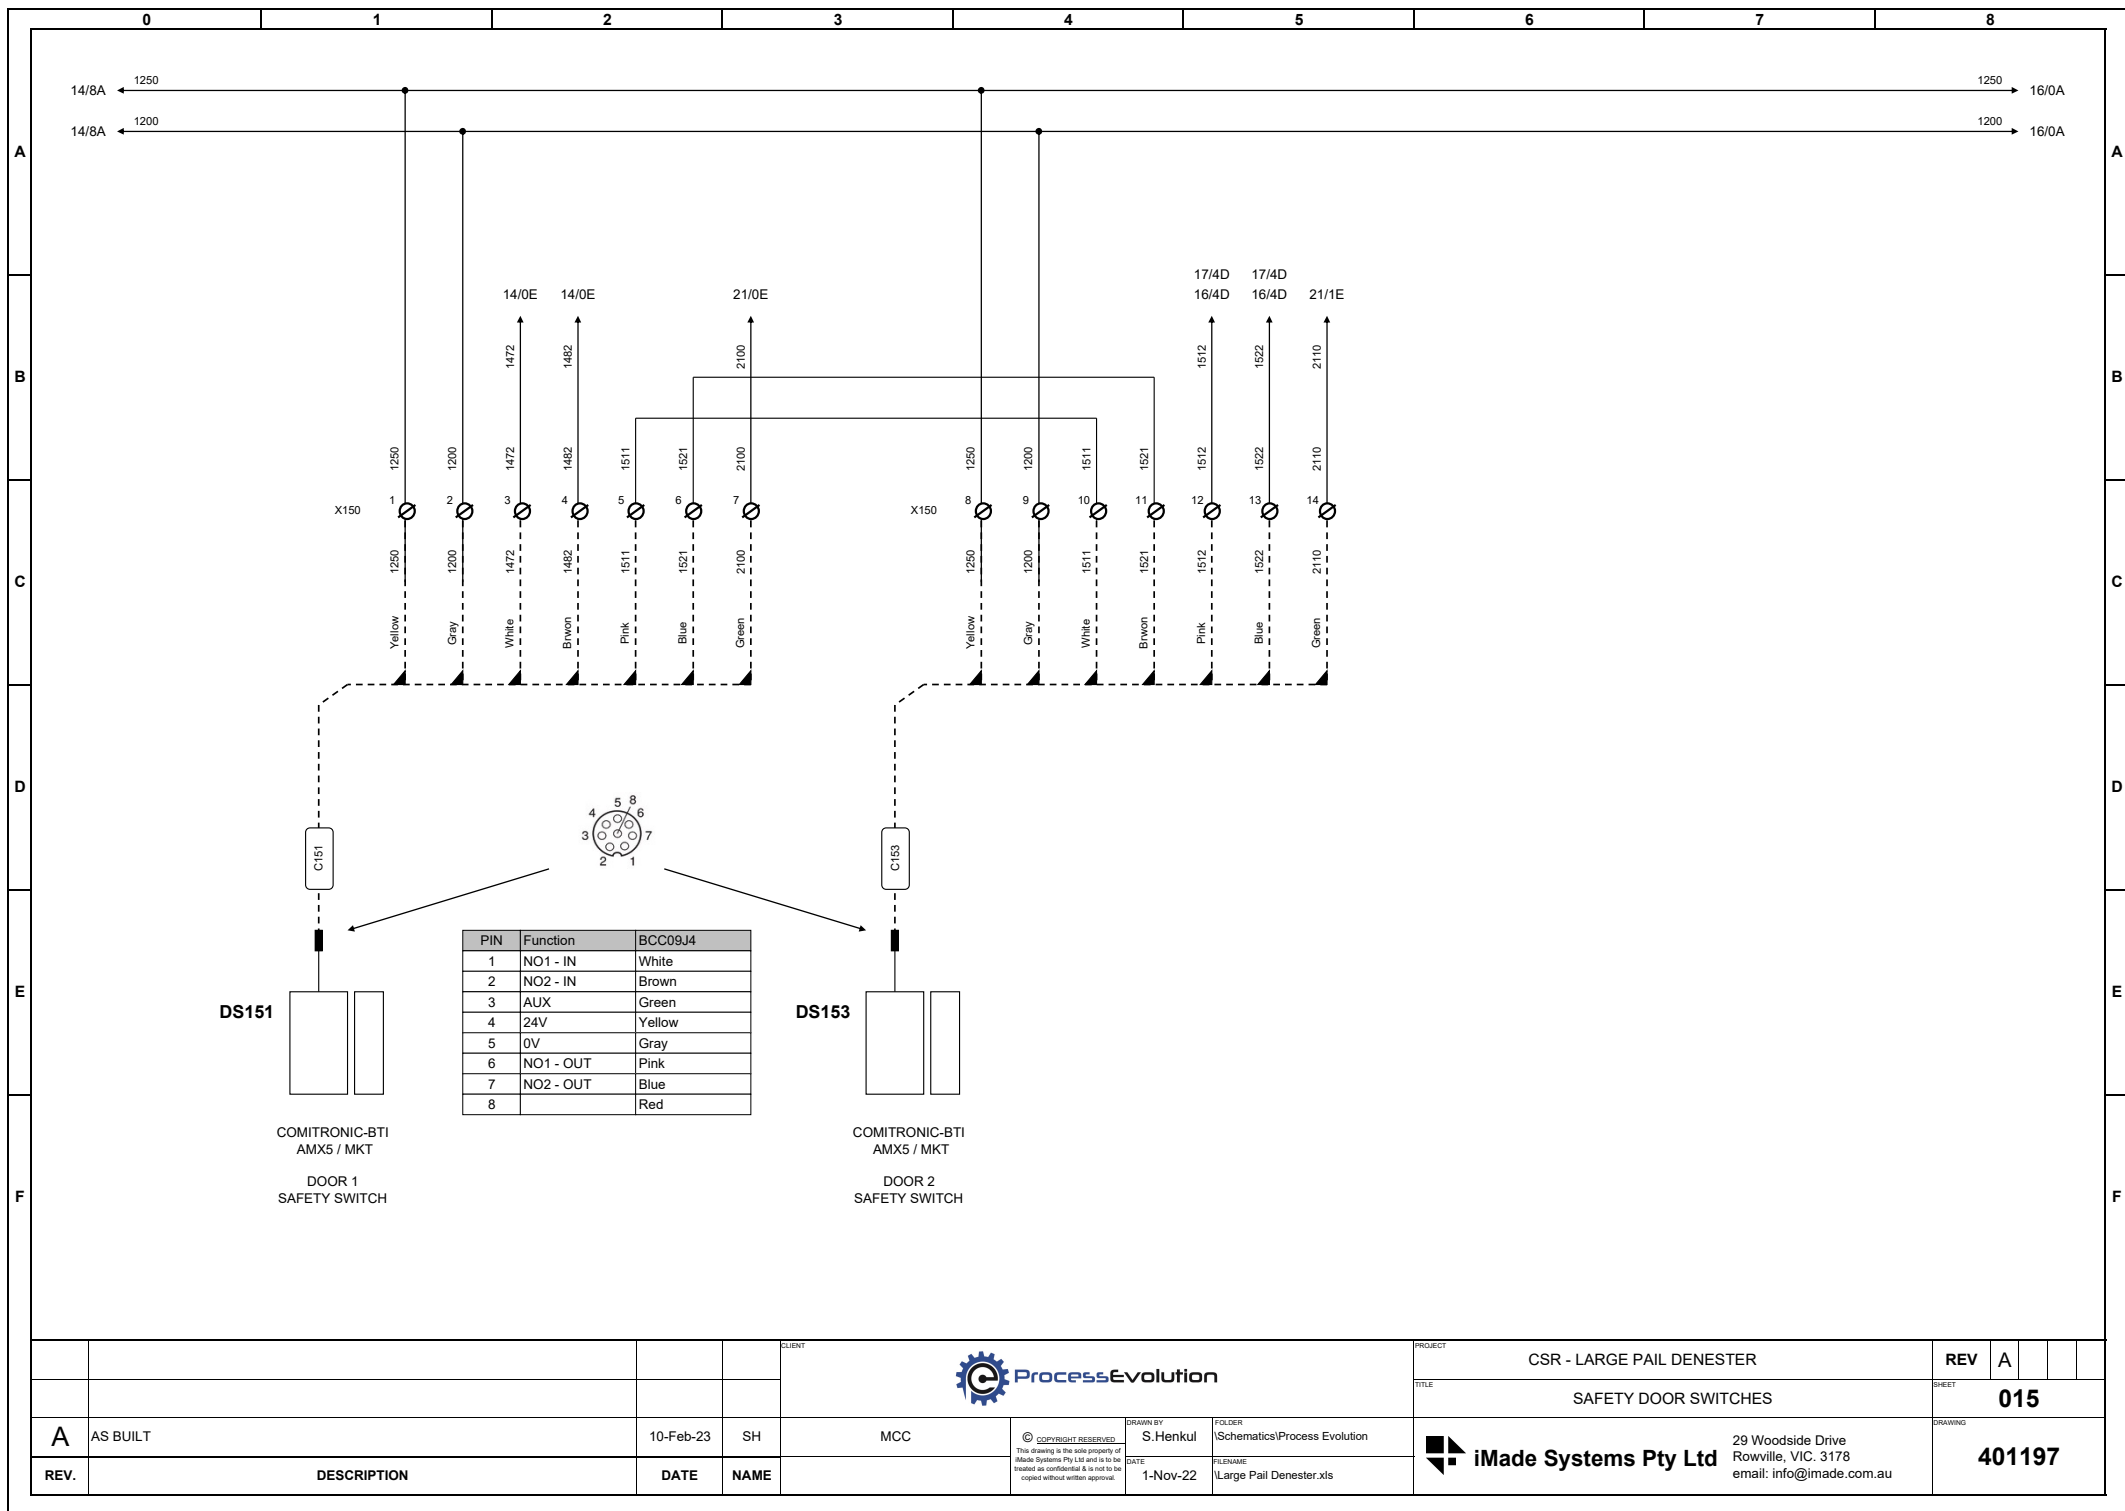

PROJECT		CSR - LARGE PAIL DENESTER		REV	A		
TITLE		SAFETY DOOR SWITCHES		SHEET		015	
DRAWN BY		S.Henkul		DRAWING		401197	
FOLDER		ISchematics/Process Evolution		DATE		1-Nov-22	
FILENAME		Large Pail Denester.xls		CLIENT		MCC	
DESCRIPTION		DATE		NAME		SH	
REV.		AS BUILT		10-Feb-23		SH	



**iMade Systems Pty Ltd**  
29 Woodside Drive  
Rowville, VIC. 3178  
email: info@imade.com.au

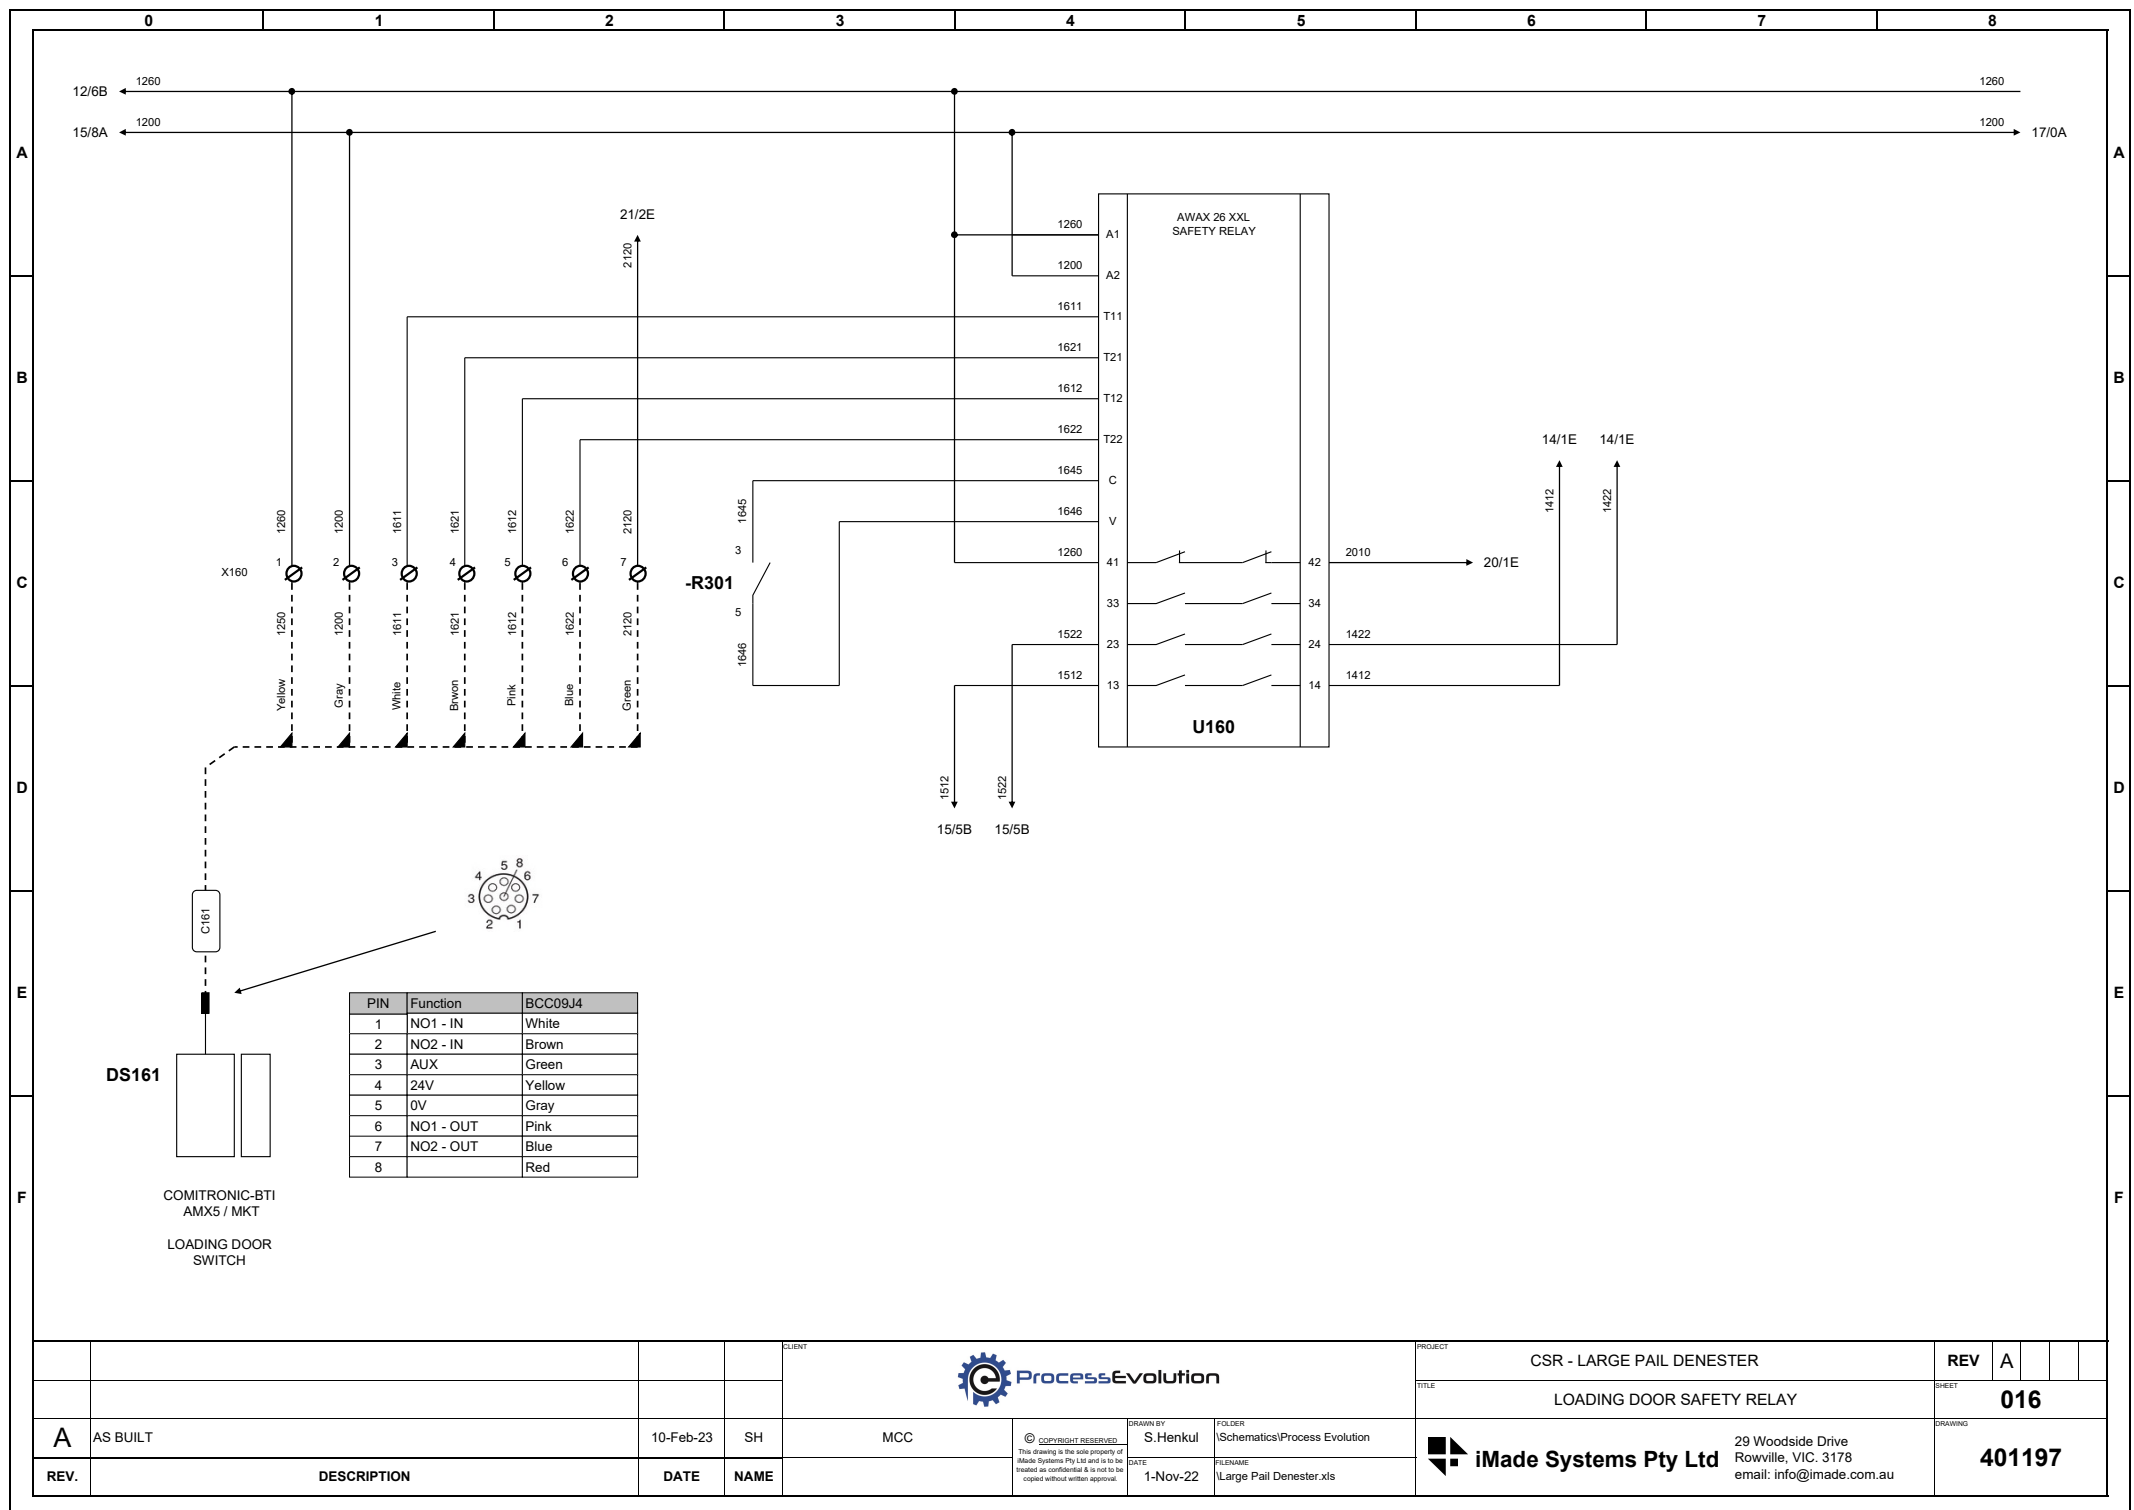




PROJECT		CSR - LARGE PAIL DENESTER		REV	A		
TITLE		LOADING DOOR SAFETY RELAY		SHEET	016		
DRAWING		iMade Systems Pty Ltd 29 Woodside Drive Rowville, VIC. 3178 email: info@imade.com.au		401197			

A	AS BUILT	10-Feb-23	SH	MCC
REV.	DESCRIPTION	DATE	NAME	

DRAWN BY		S.Henkul		FOLDER		ISchematics/Process Evolution	
DATE		1-Nov-22		FILENAME		Large Pail Denester.xls	

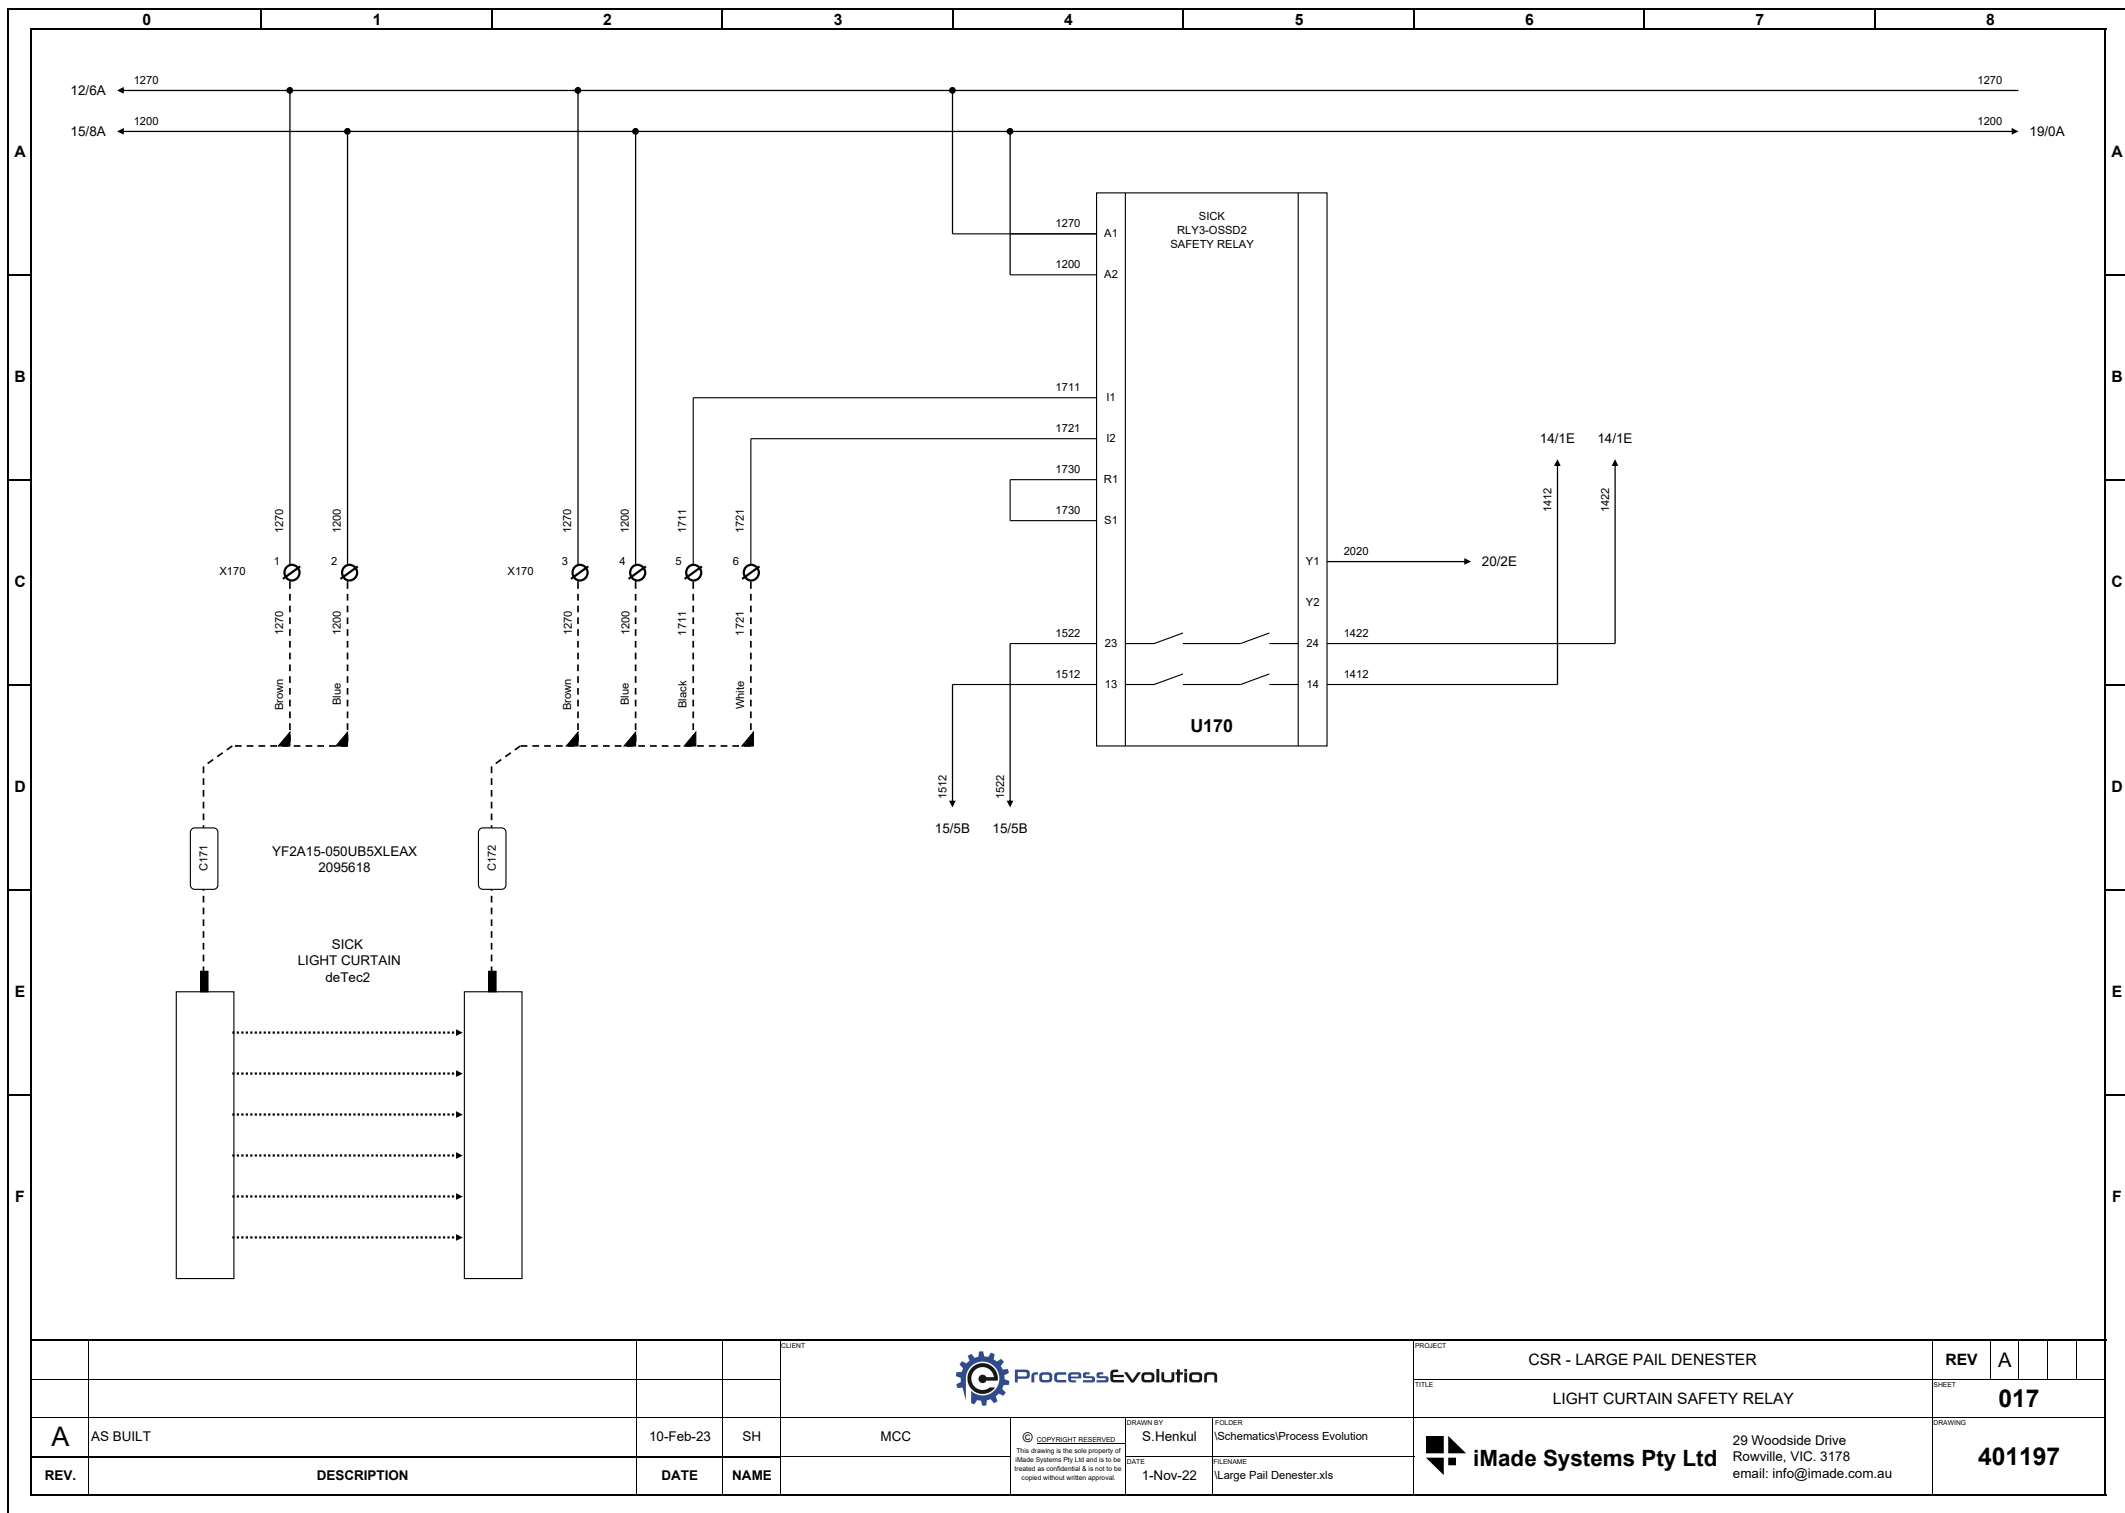29 Woodside Drive  
Rowville, VIC. 3178  
email: info@imade.com.au





				<div>CLIENT</div> <div></div>				<div>PROJECT</div> <div>CSR - LARGE PAIL DENESTER</div>		REV	A			
								<div>TITLE</div> <div>LIGHT CURTAIN SAFETY RELAY</div>		SHEET	017			
A	AS BUILT		10-Feb-23	SH	MCC	<div>© COPYRIGHT RESERVED</div> <div>This drawing is the sole property of Made Systems Pty Ltd and is to be treated as confidential &amp; is not to be copied without written approval.</div>	DRAWN BY S.Henkul	FOLDER ISchematics\Process Evolution	<div> iMade Systems Pty Ltd</div> <div>29 Woodside Drive Rowville, VIC. 3178 email: info@imade.com.au</div>		<div>DRAWING</div> <div>401197</div>			
REV.	DESCRIPTION		DATE	NAME			DATE 1-Nov-22	FILENAME Large Pail Denester.xls						









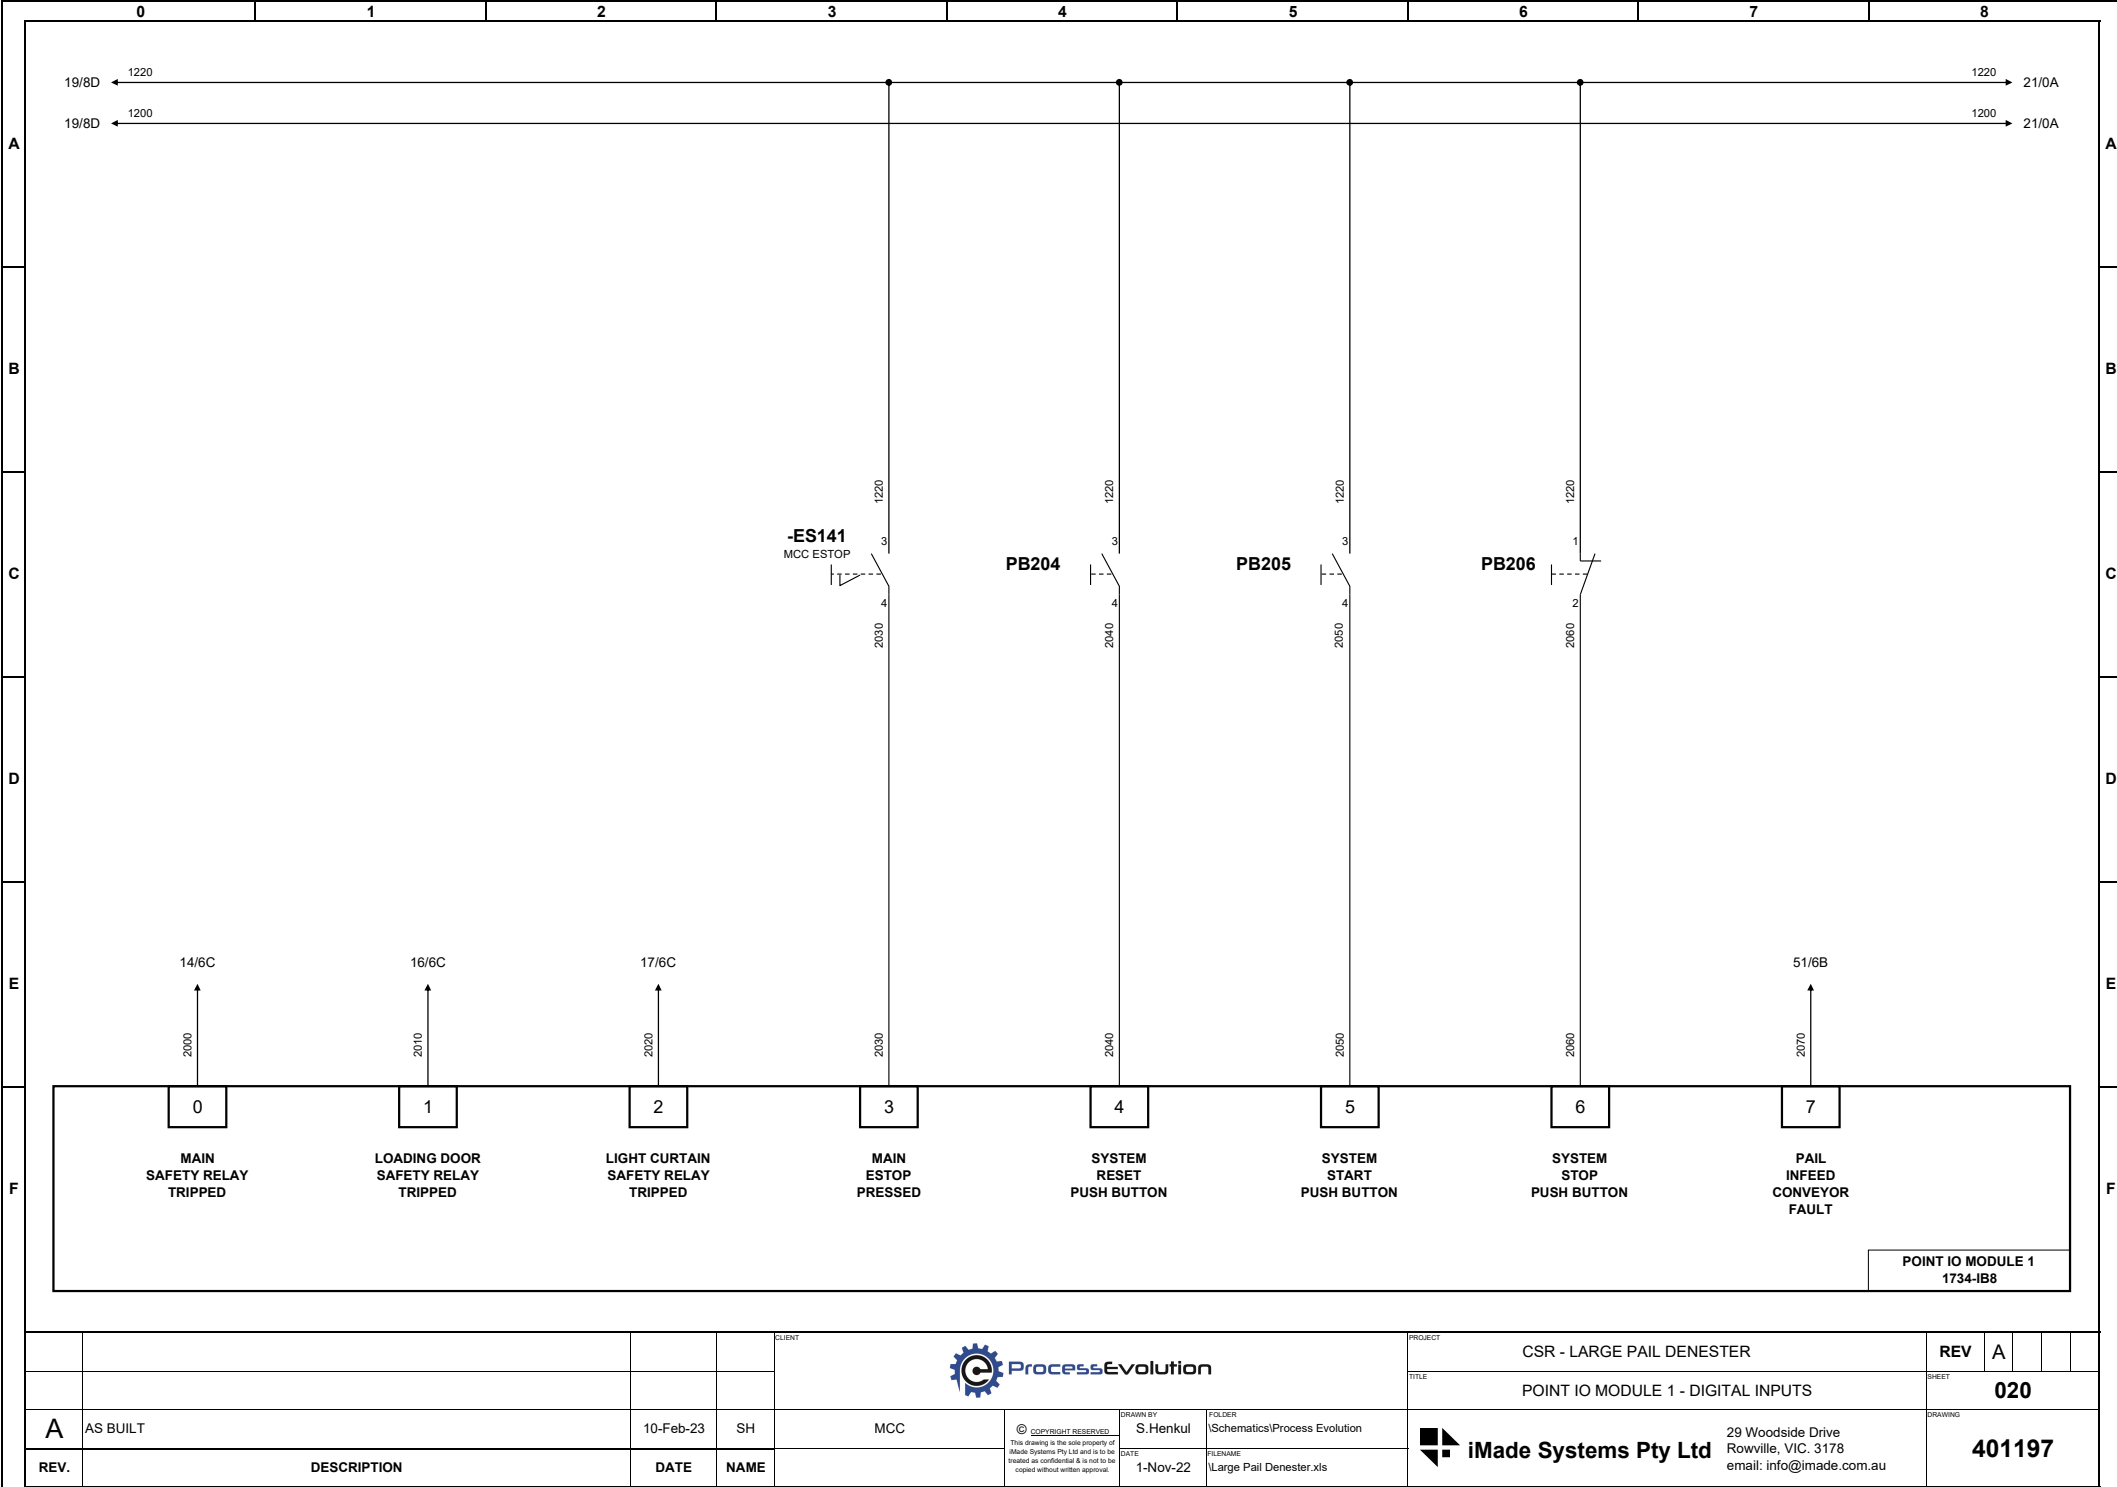


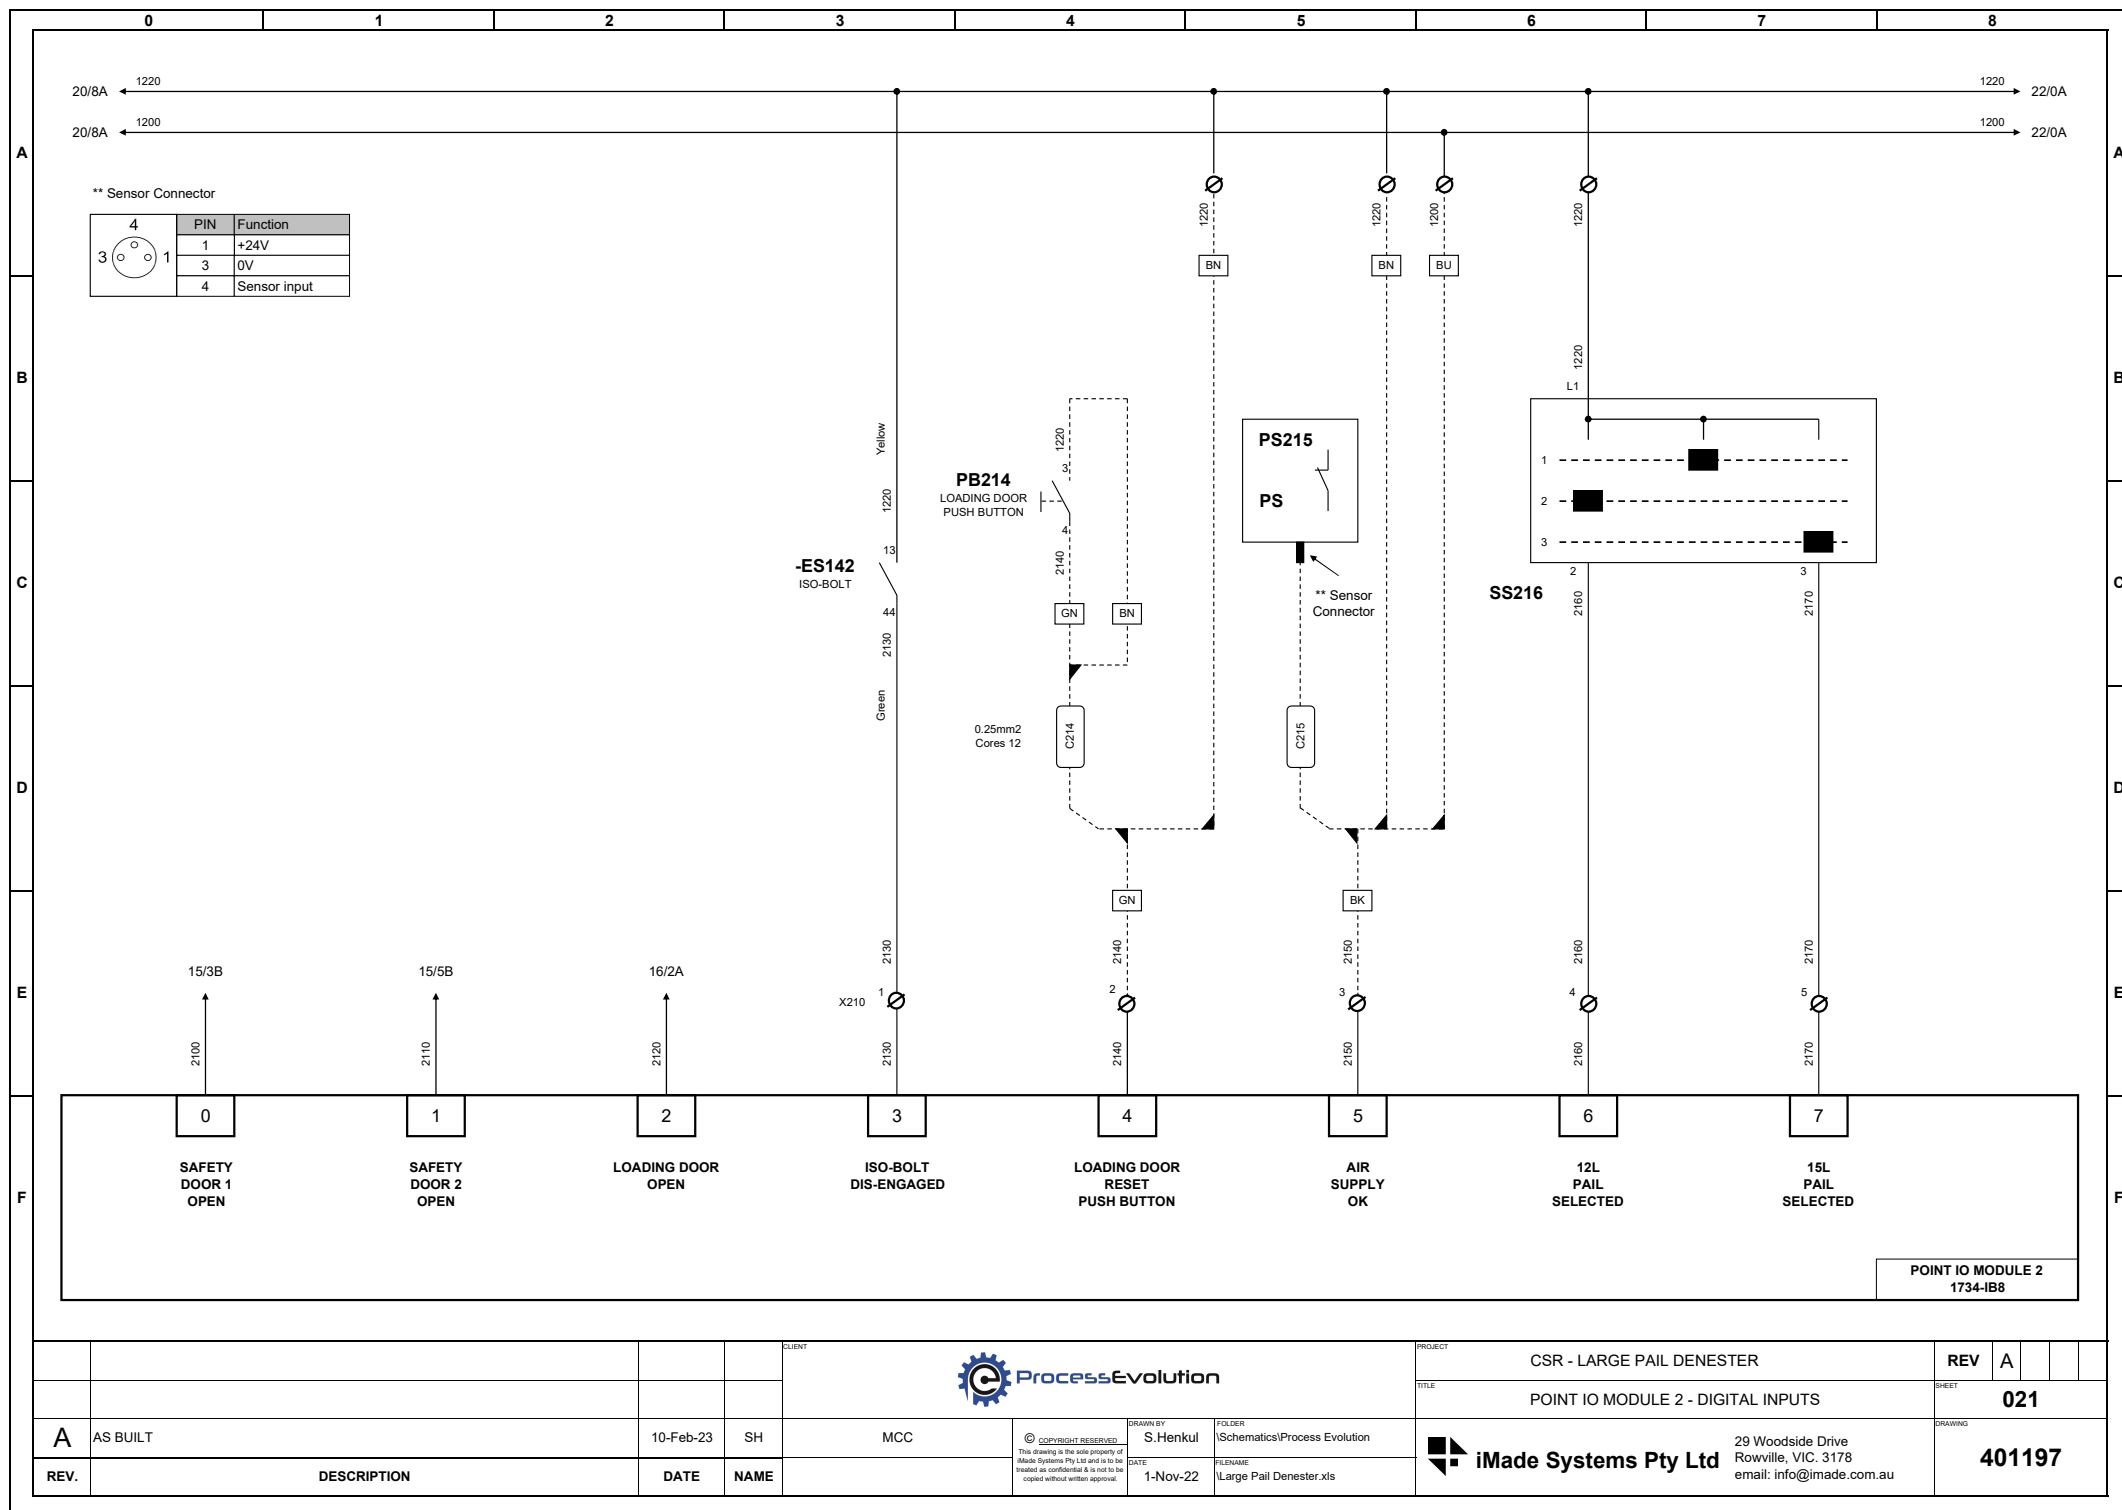



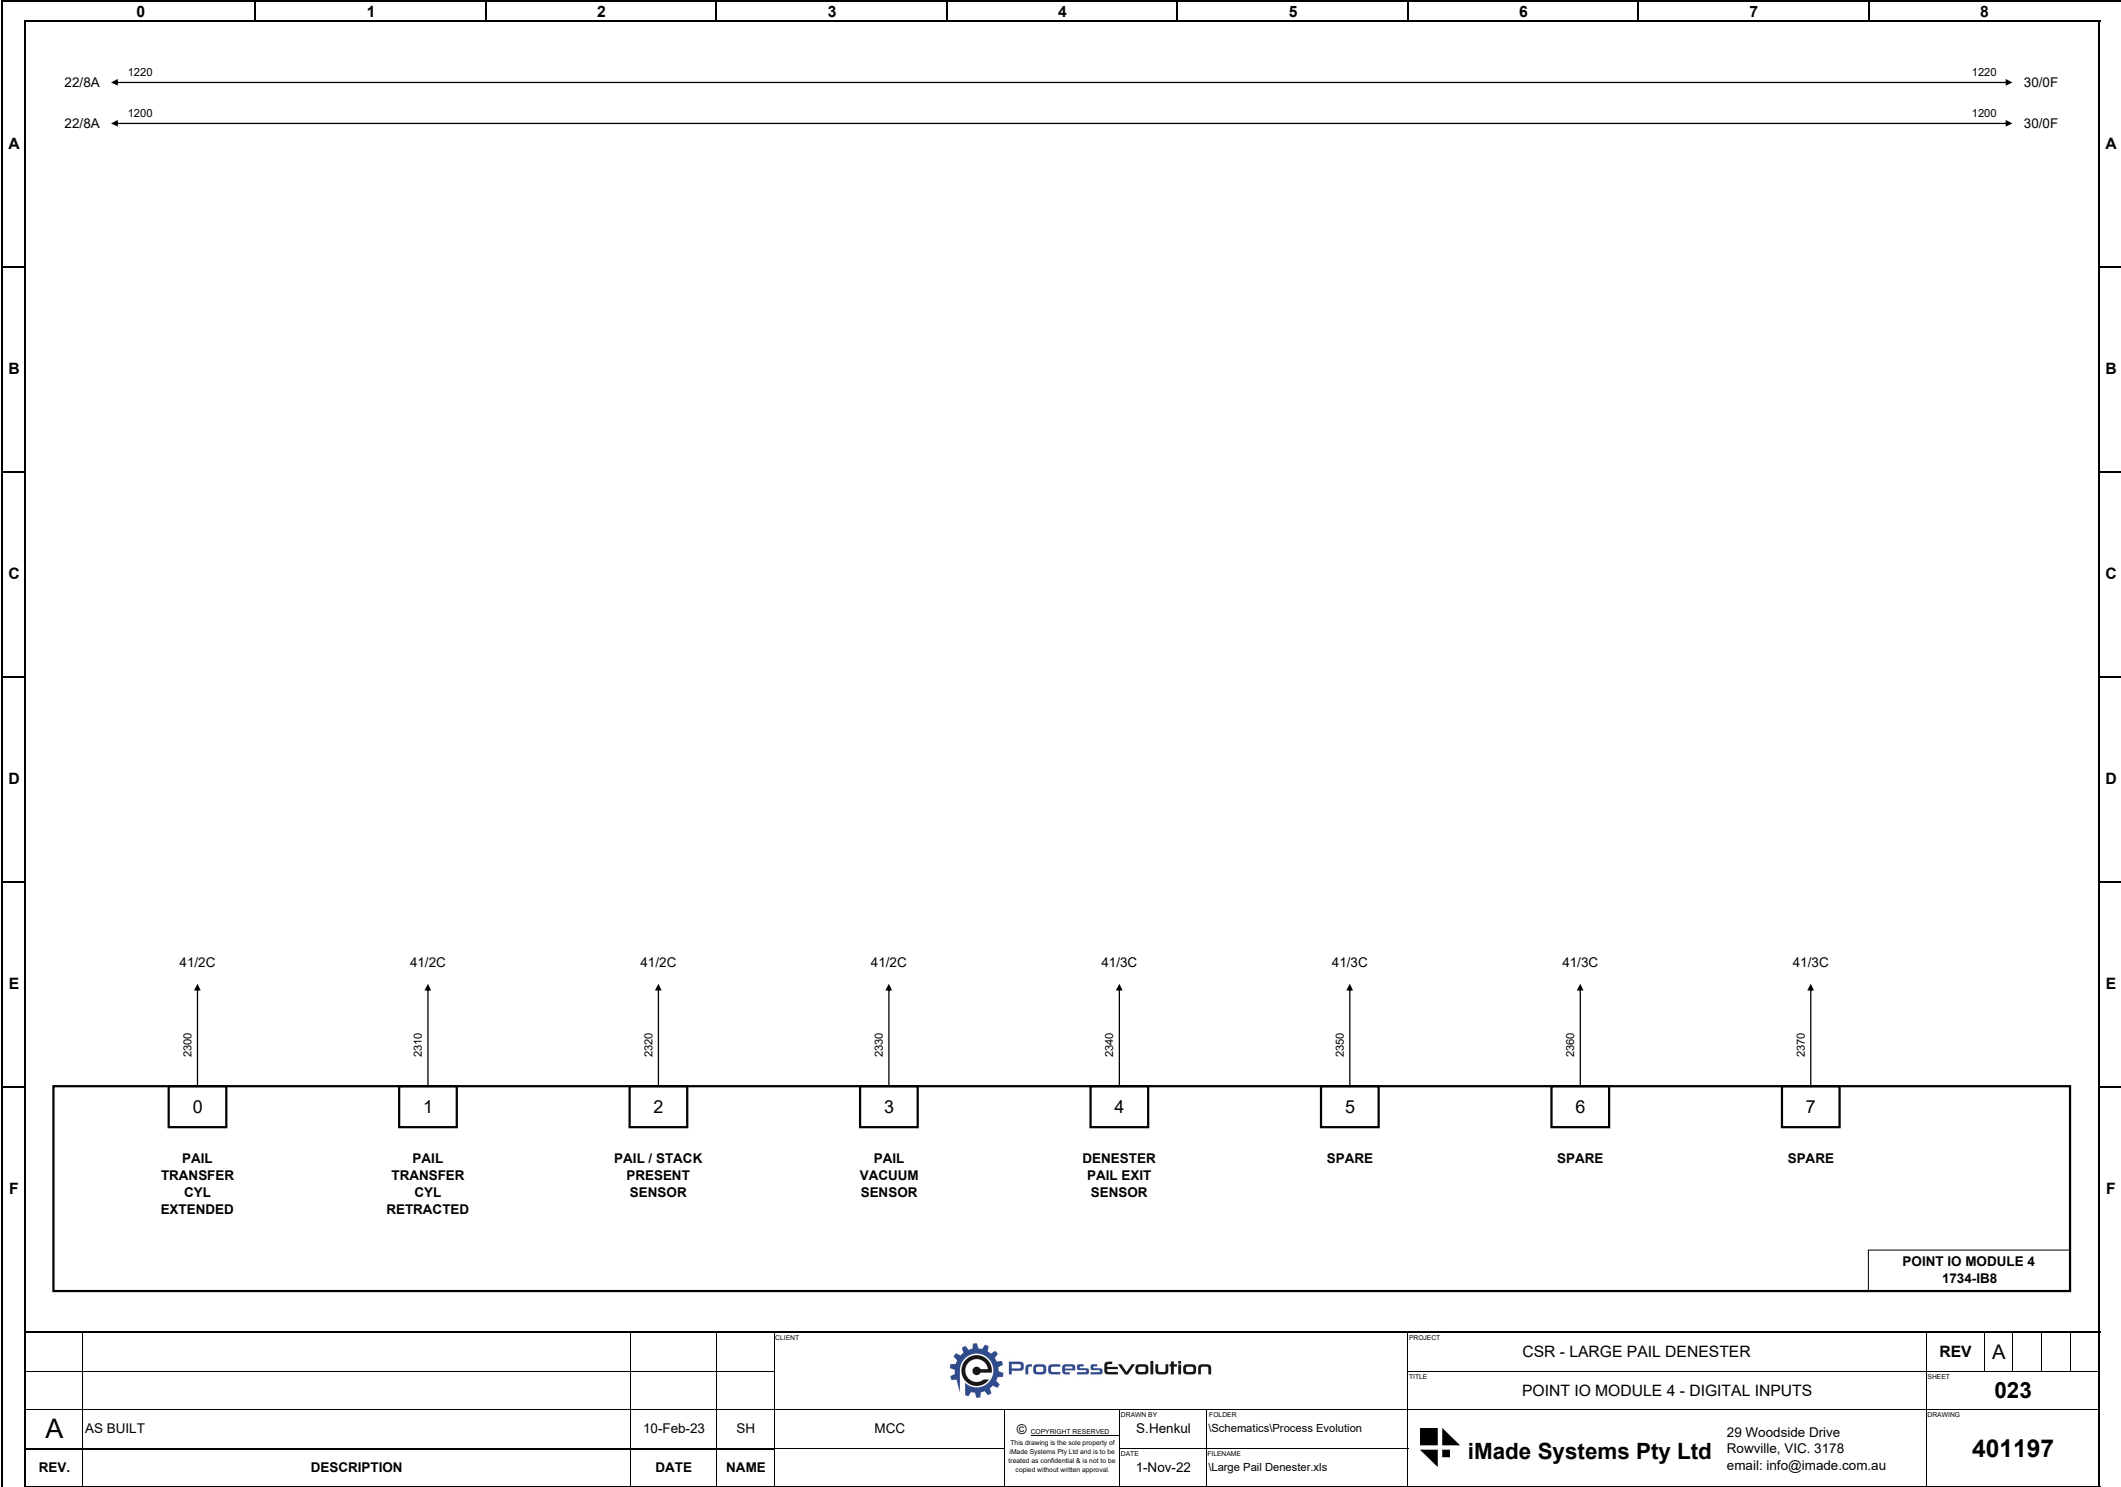


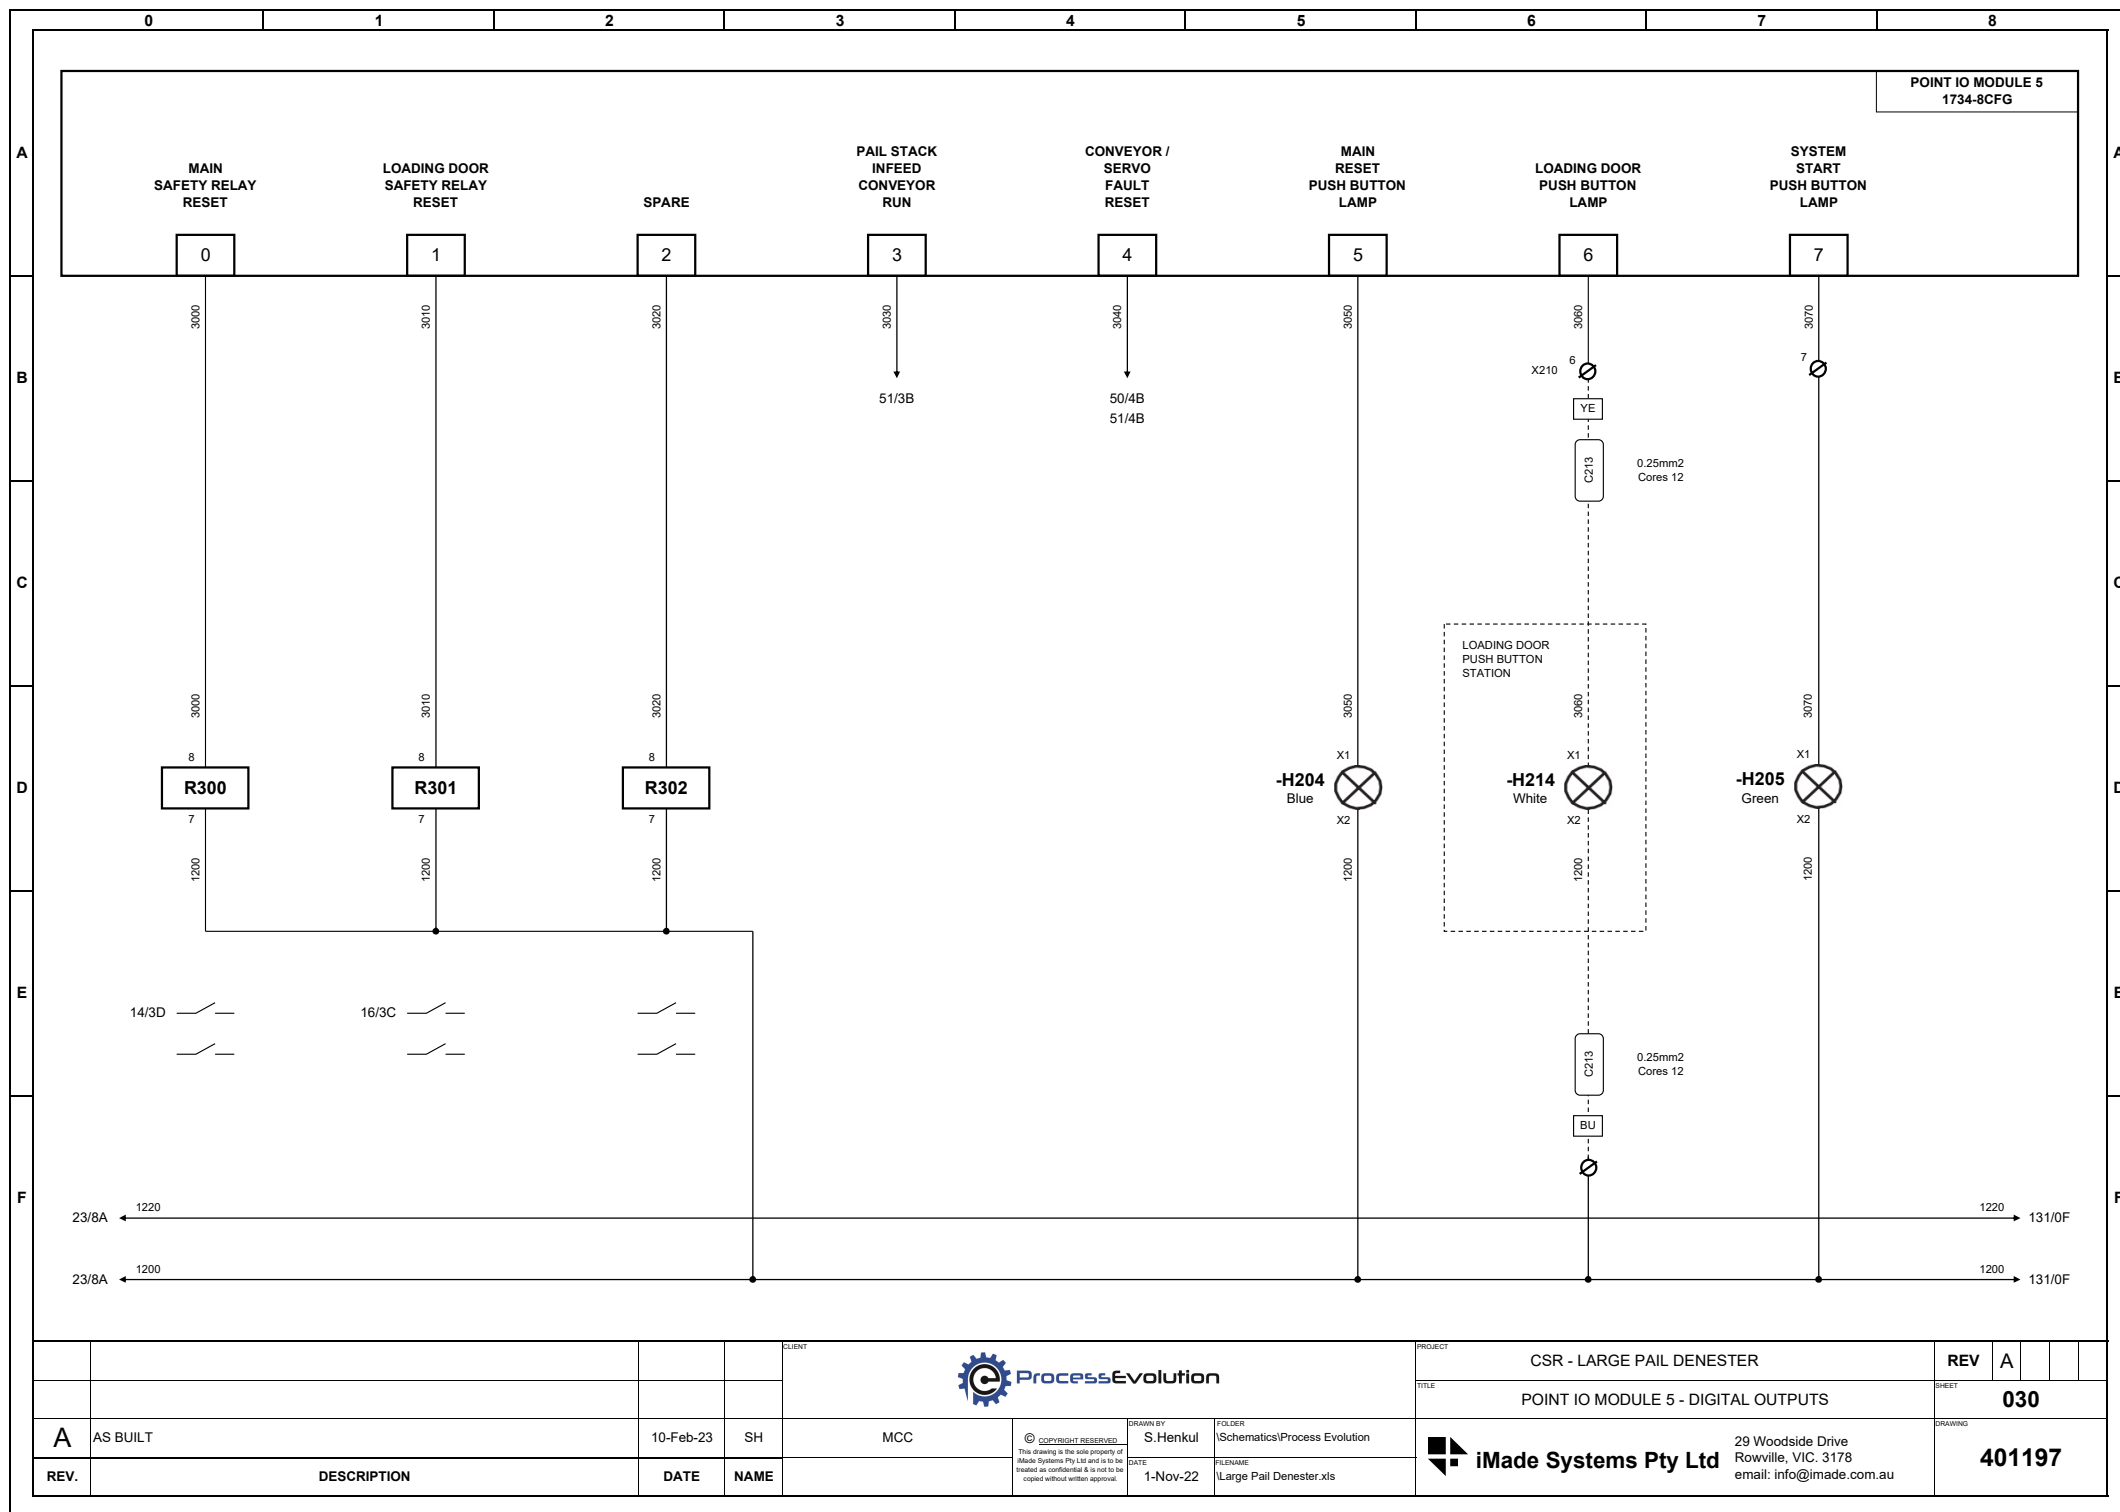

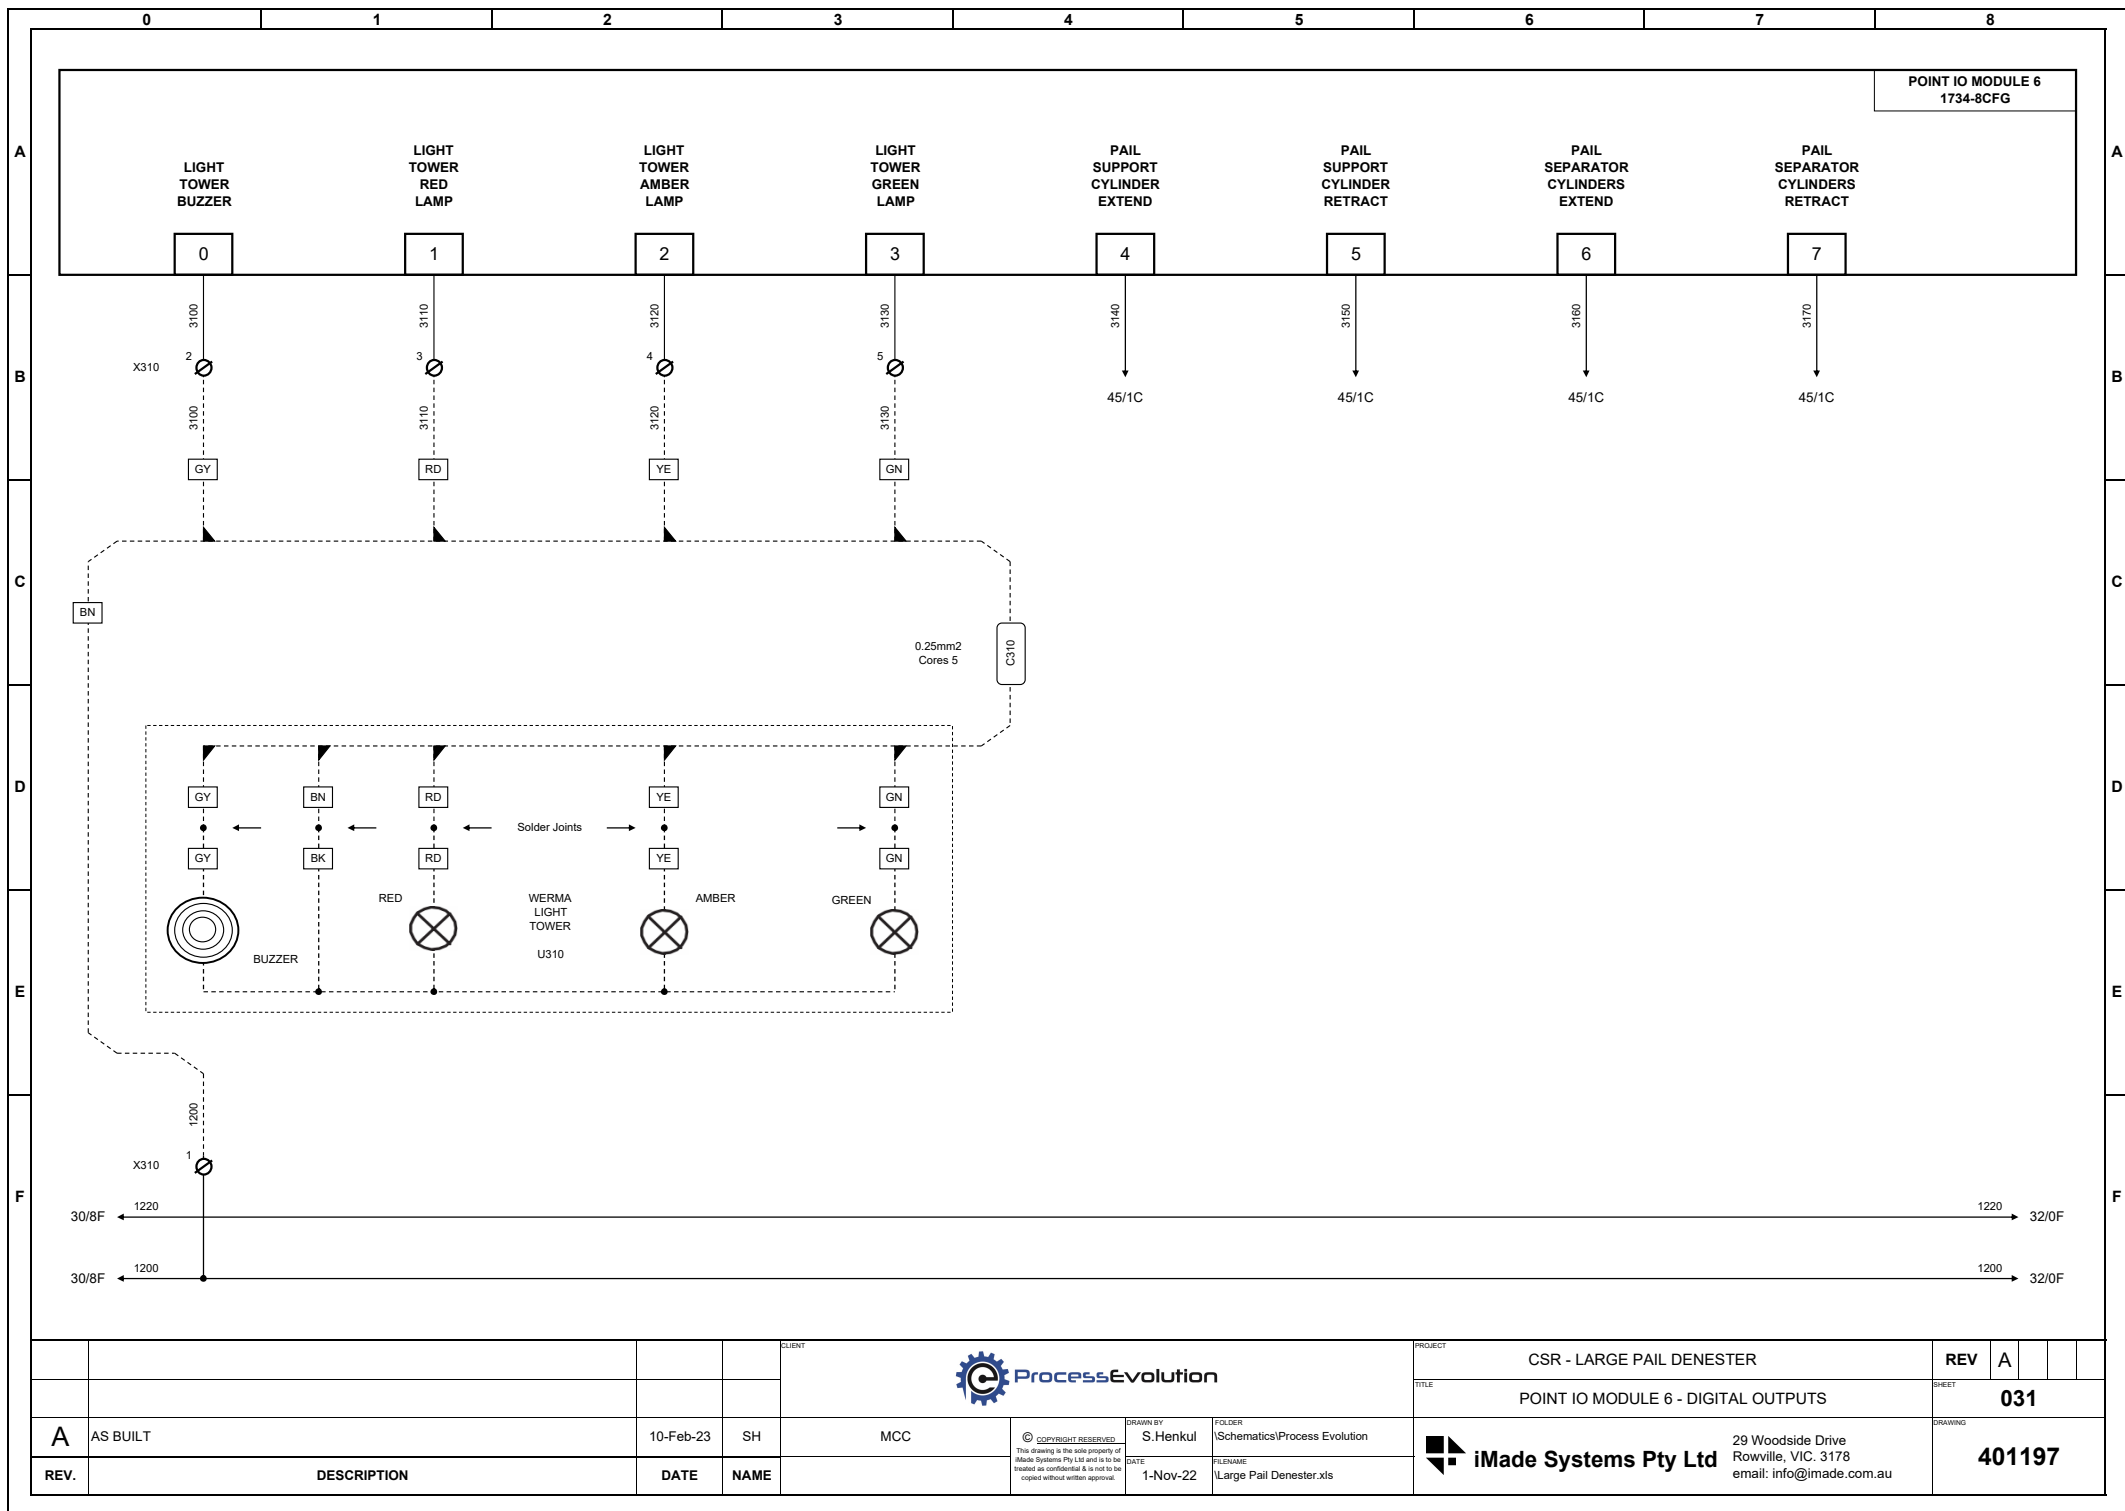






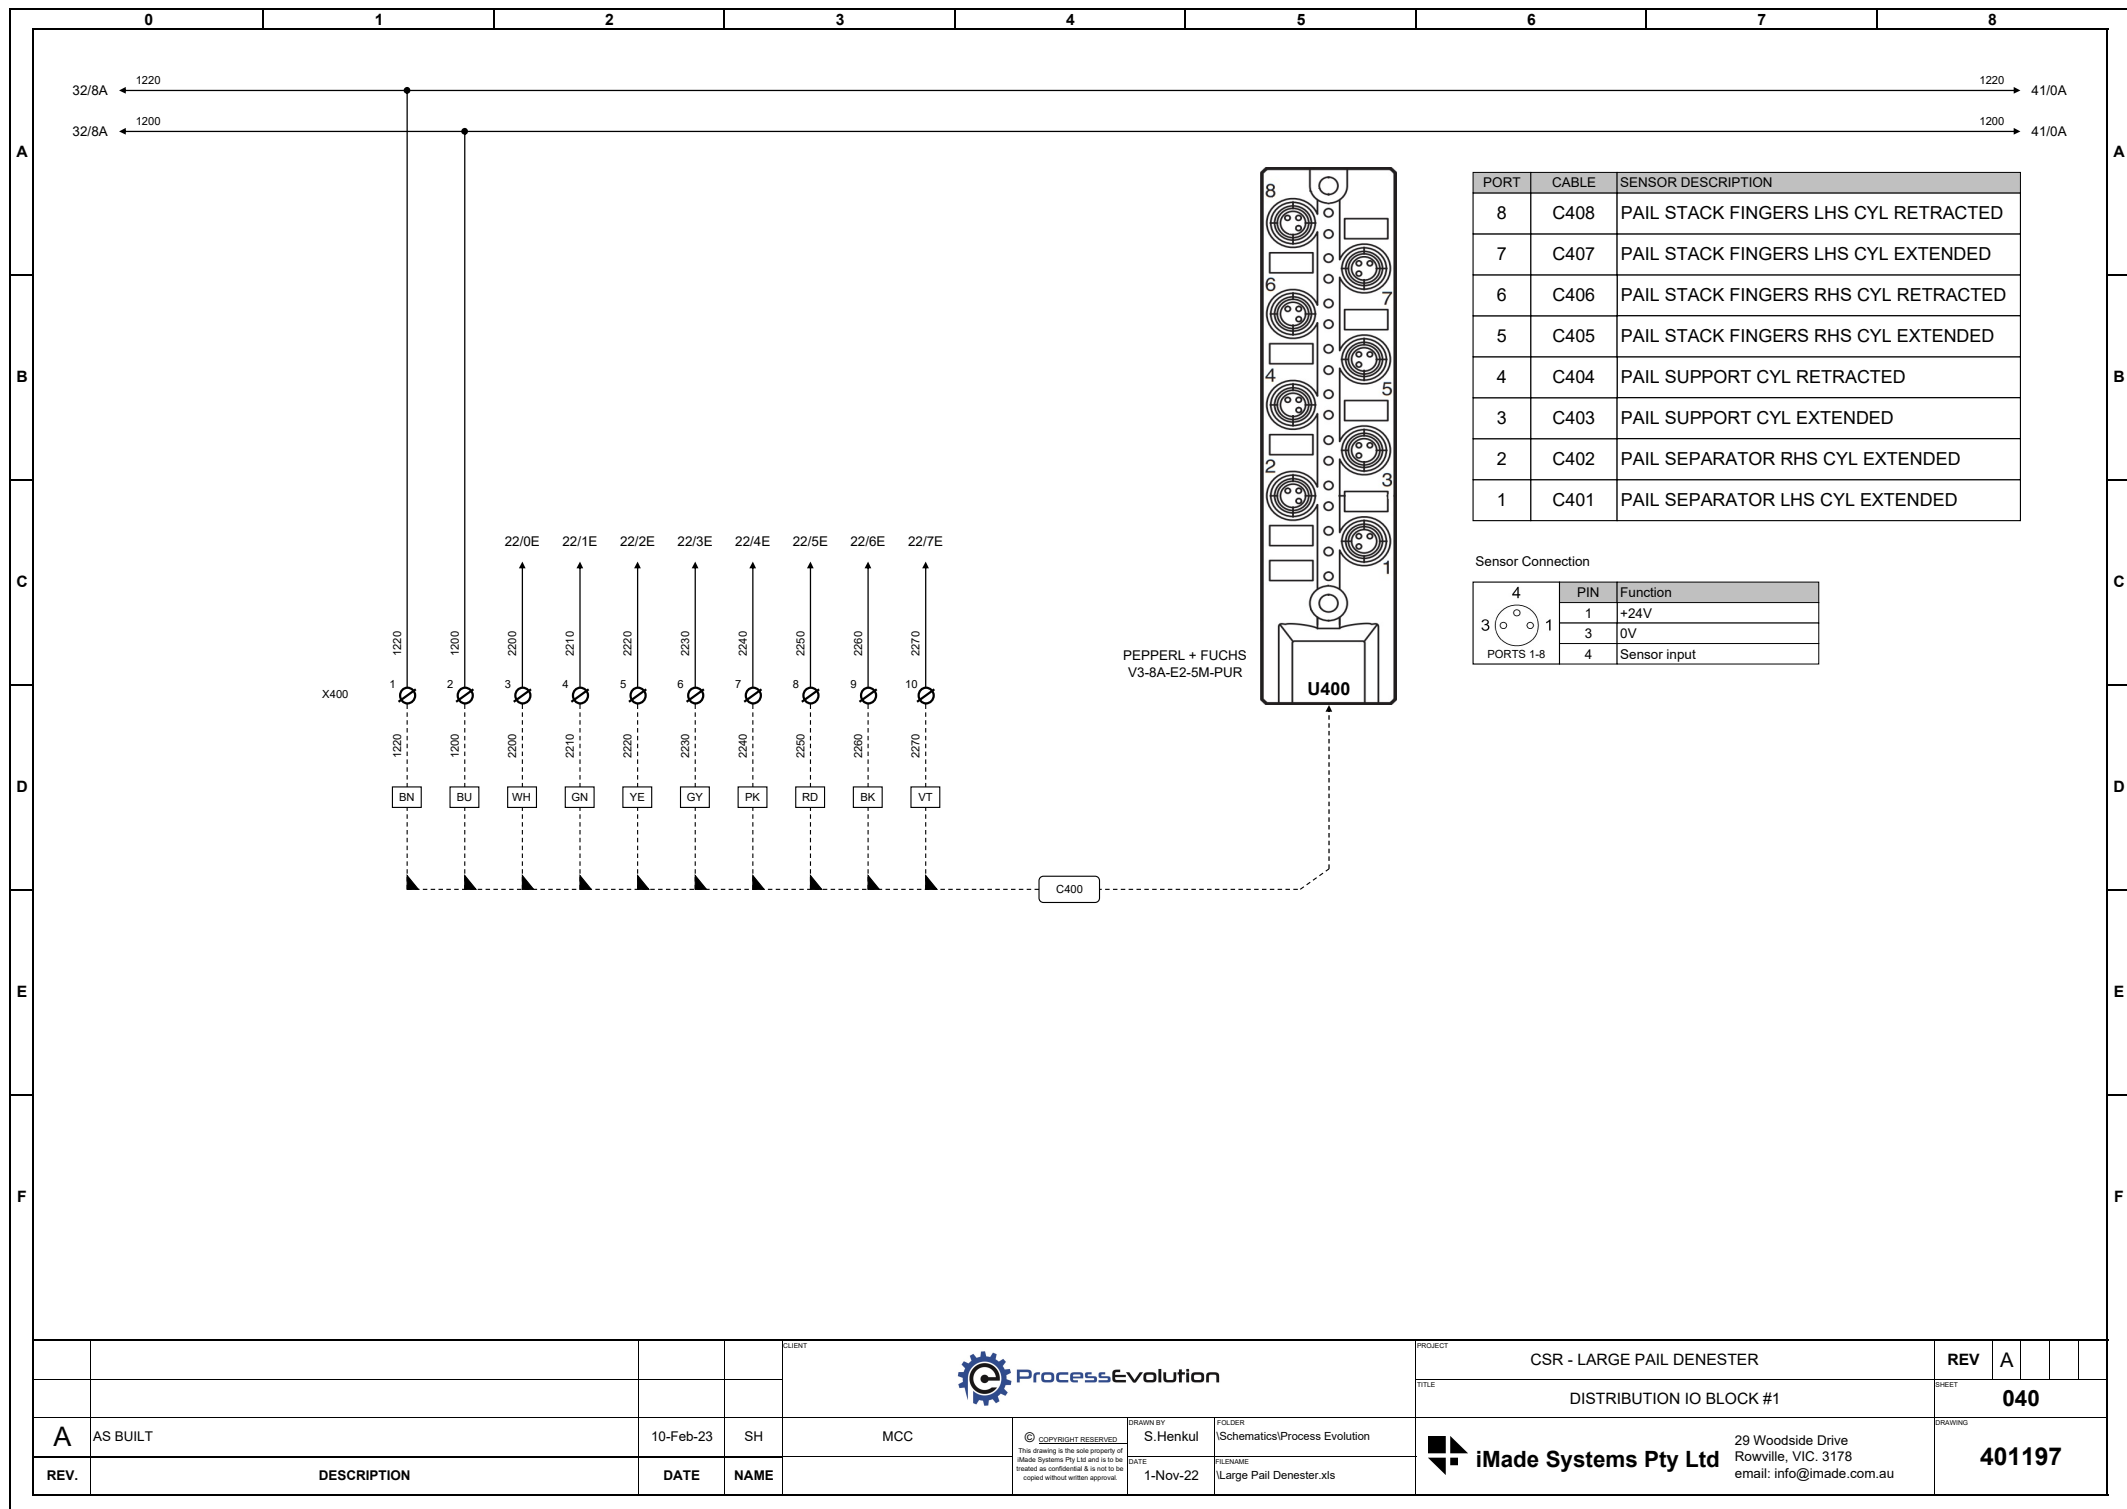



				<div></div>				PROJECT				CSR - LARGE PAIL DENESTER		REV	A								
												TITLE				DISTRIBUTION IO BLOCK #1				SHEET		040	
A	AS BUILT			10-Feb-23	SH	MCC	<div><div>© COPYRIGHT RESERVED</div><div>This drawing is the sole property of iMade Systems Pty Ltd and is to be treated as confidential &amp; is not to be copied without written approval.</div></div>	DRAWN BY	S.Henkul		FOLDER	ISchematics/Process Evolution		<div><div></div><div><b>iMade Systems Pty Ltd</b></div></div> <div>29 Woodside Drive Rowville, VIC. 3178 email: info@imade.com.au</div>				DRAWING				401197	
REV.	DESCRIPTION			DATE	1-Nov-22		FILENAME	Large Pail Denester.xls															

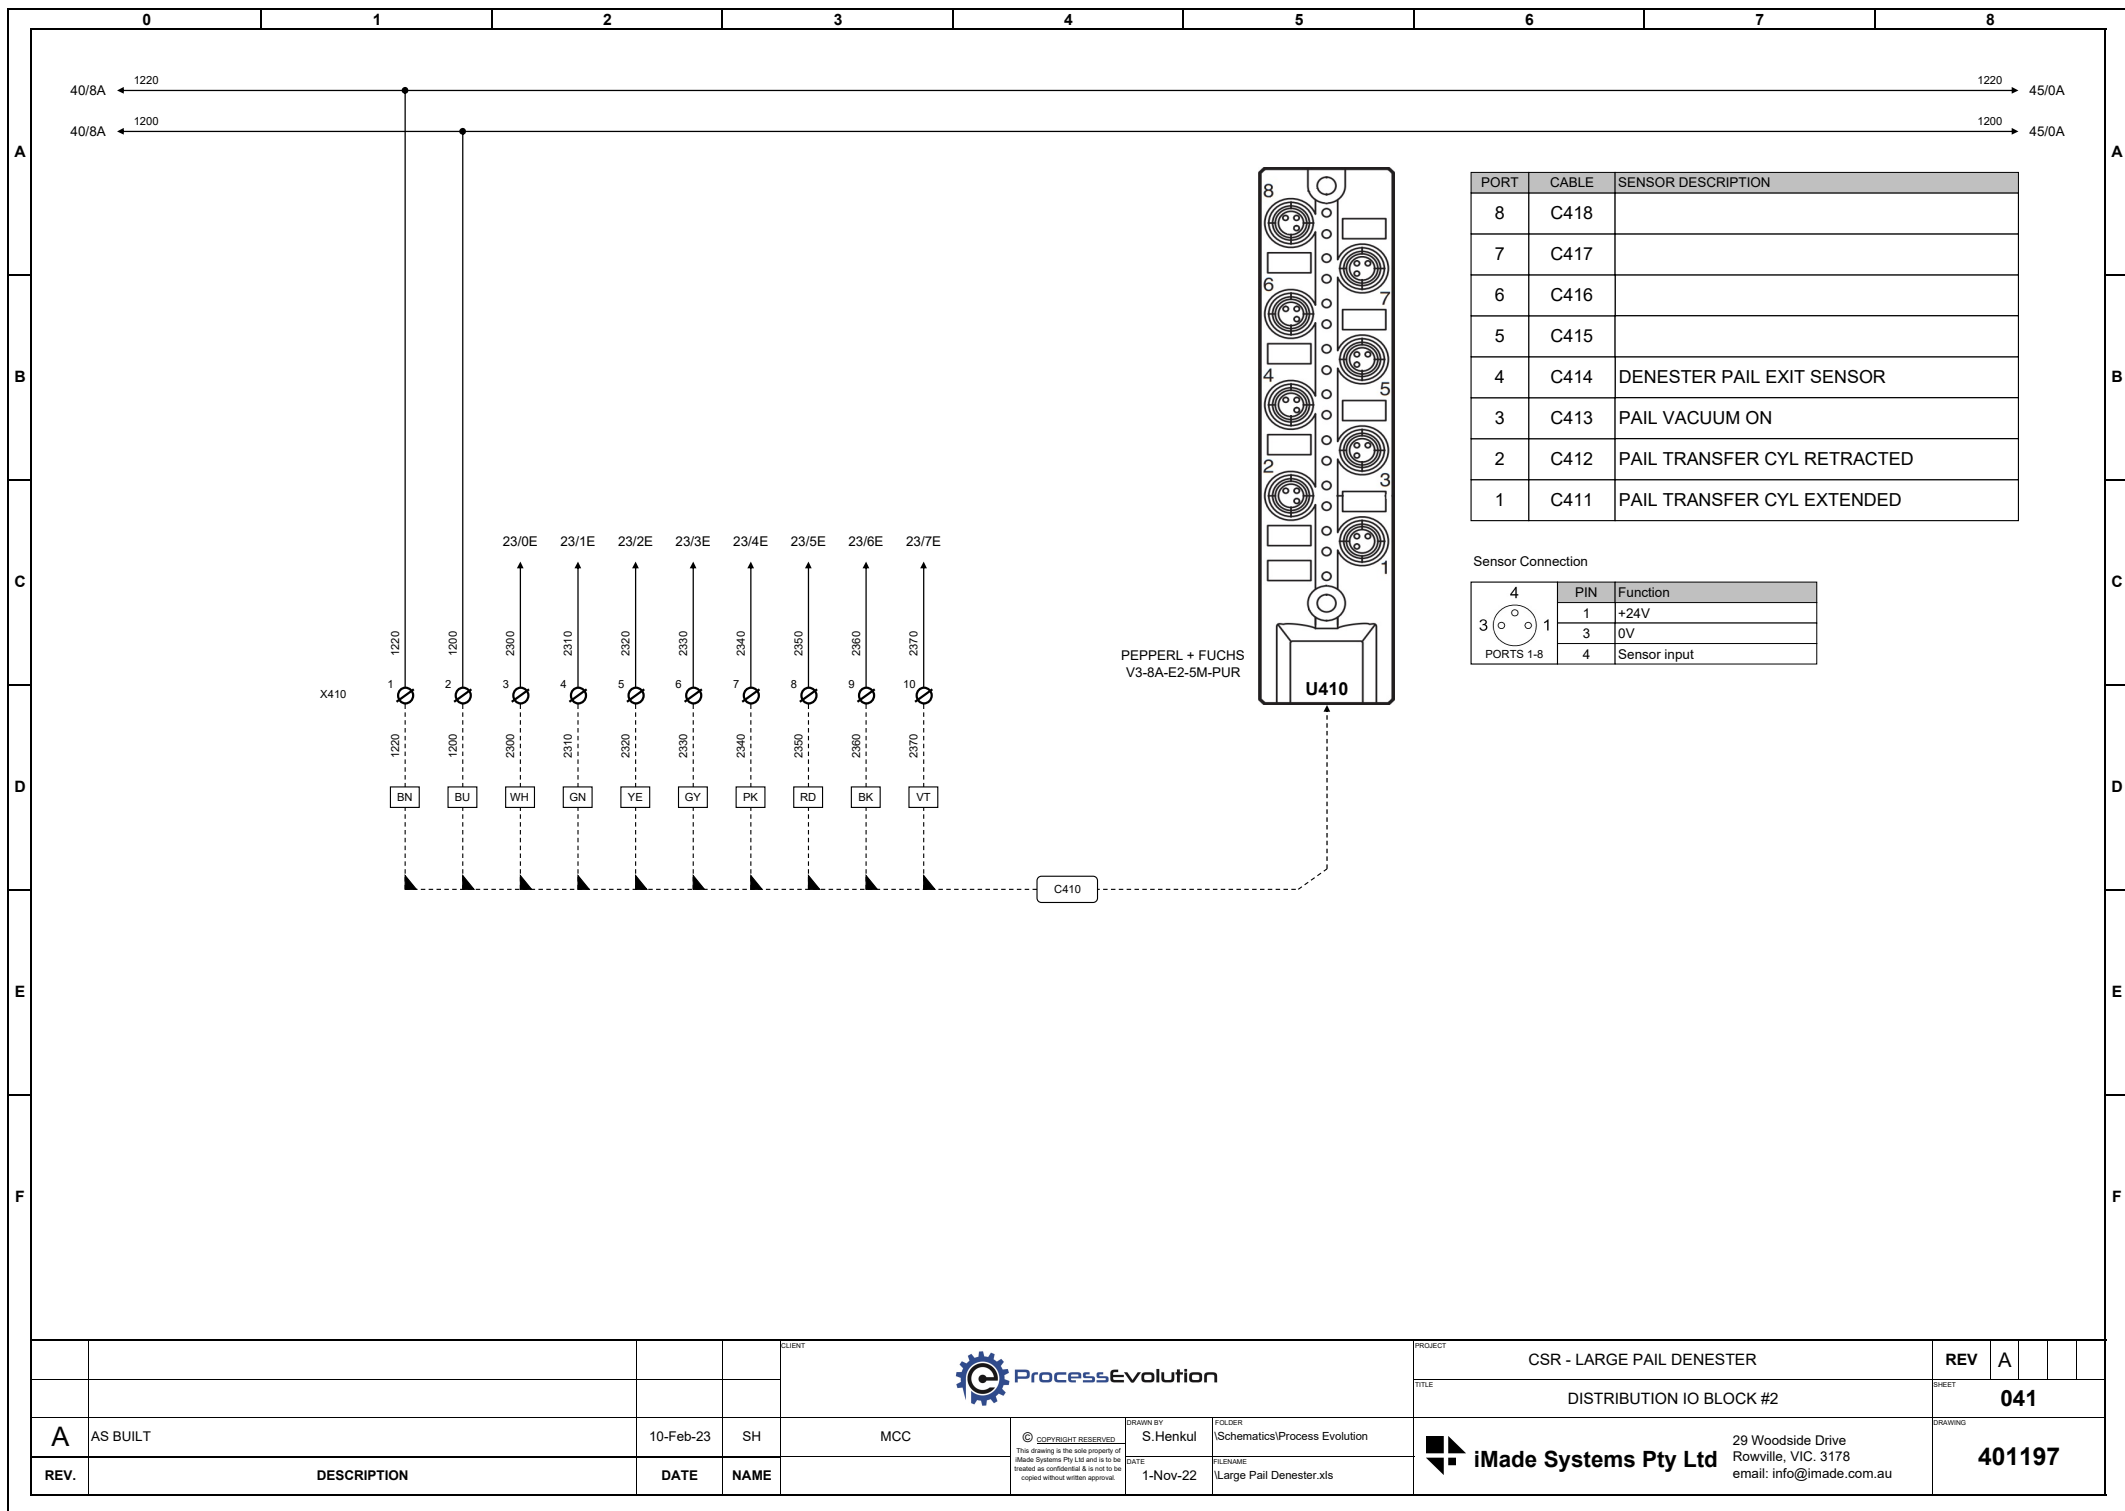

A

AS BUILT

10-Feb-23

SH

MCC

© COPYRIGHT RESERVED  
This drawing is the sole property of  
iMade Systems Pty Ltd and is to be  
treated as confidential & is not to be  
copied without written approval.

DRAWN BY  
S.Henkul

DATE  
1-Nov-22

FOLDER  
ISchematics/Process Evolution


FILENAME  
Large Pail Denester.xls




iMade Systems Pty Ltd

29 Woodside Drive  
Rowville, VIC. 3178  
email: info@imade.com.au

401197

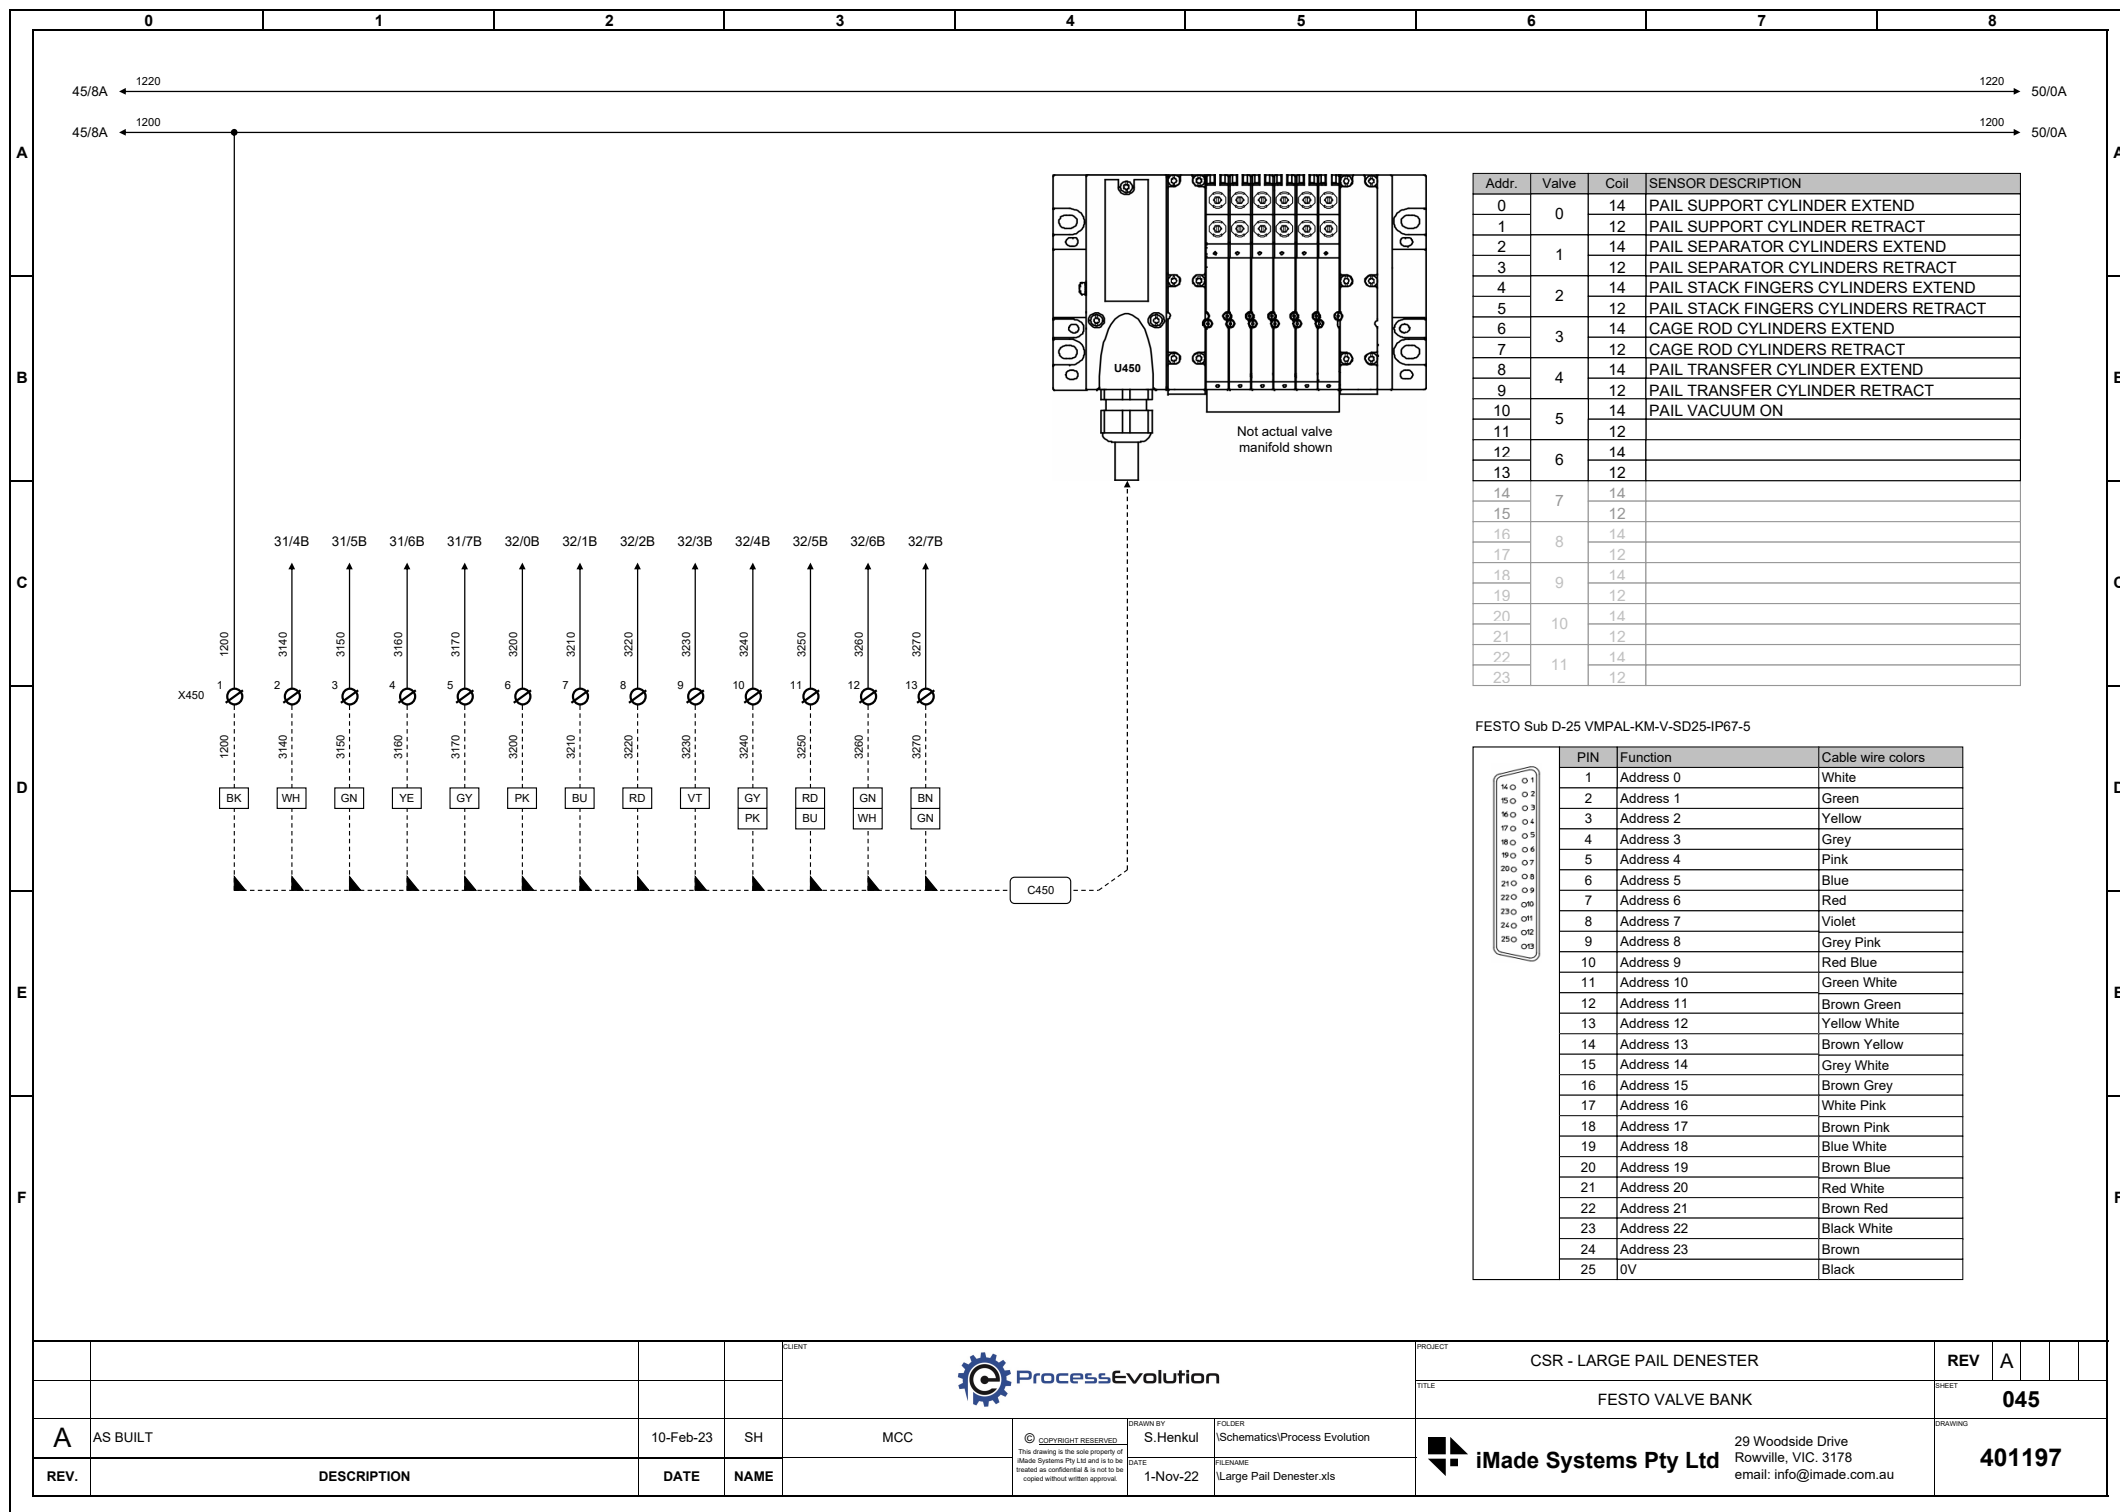

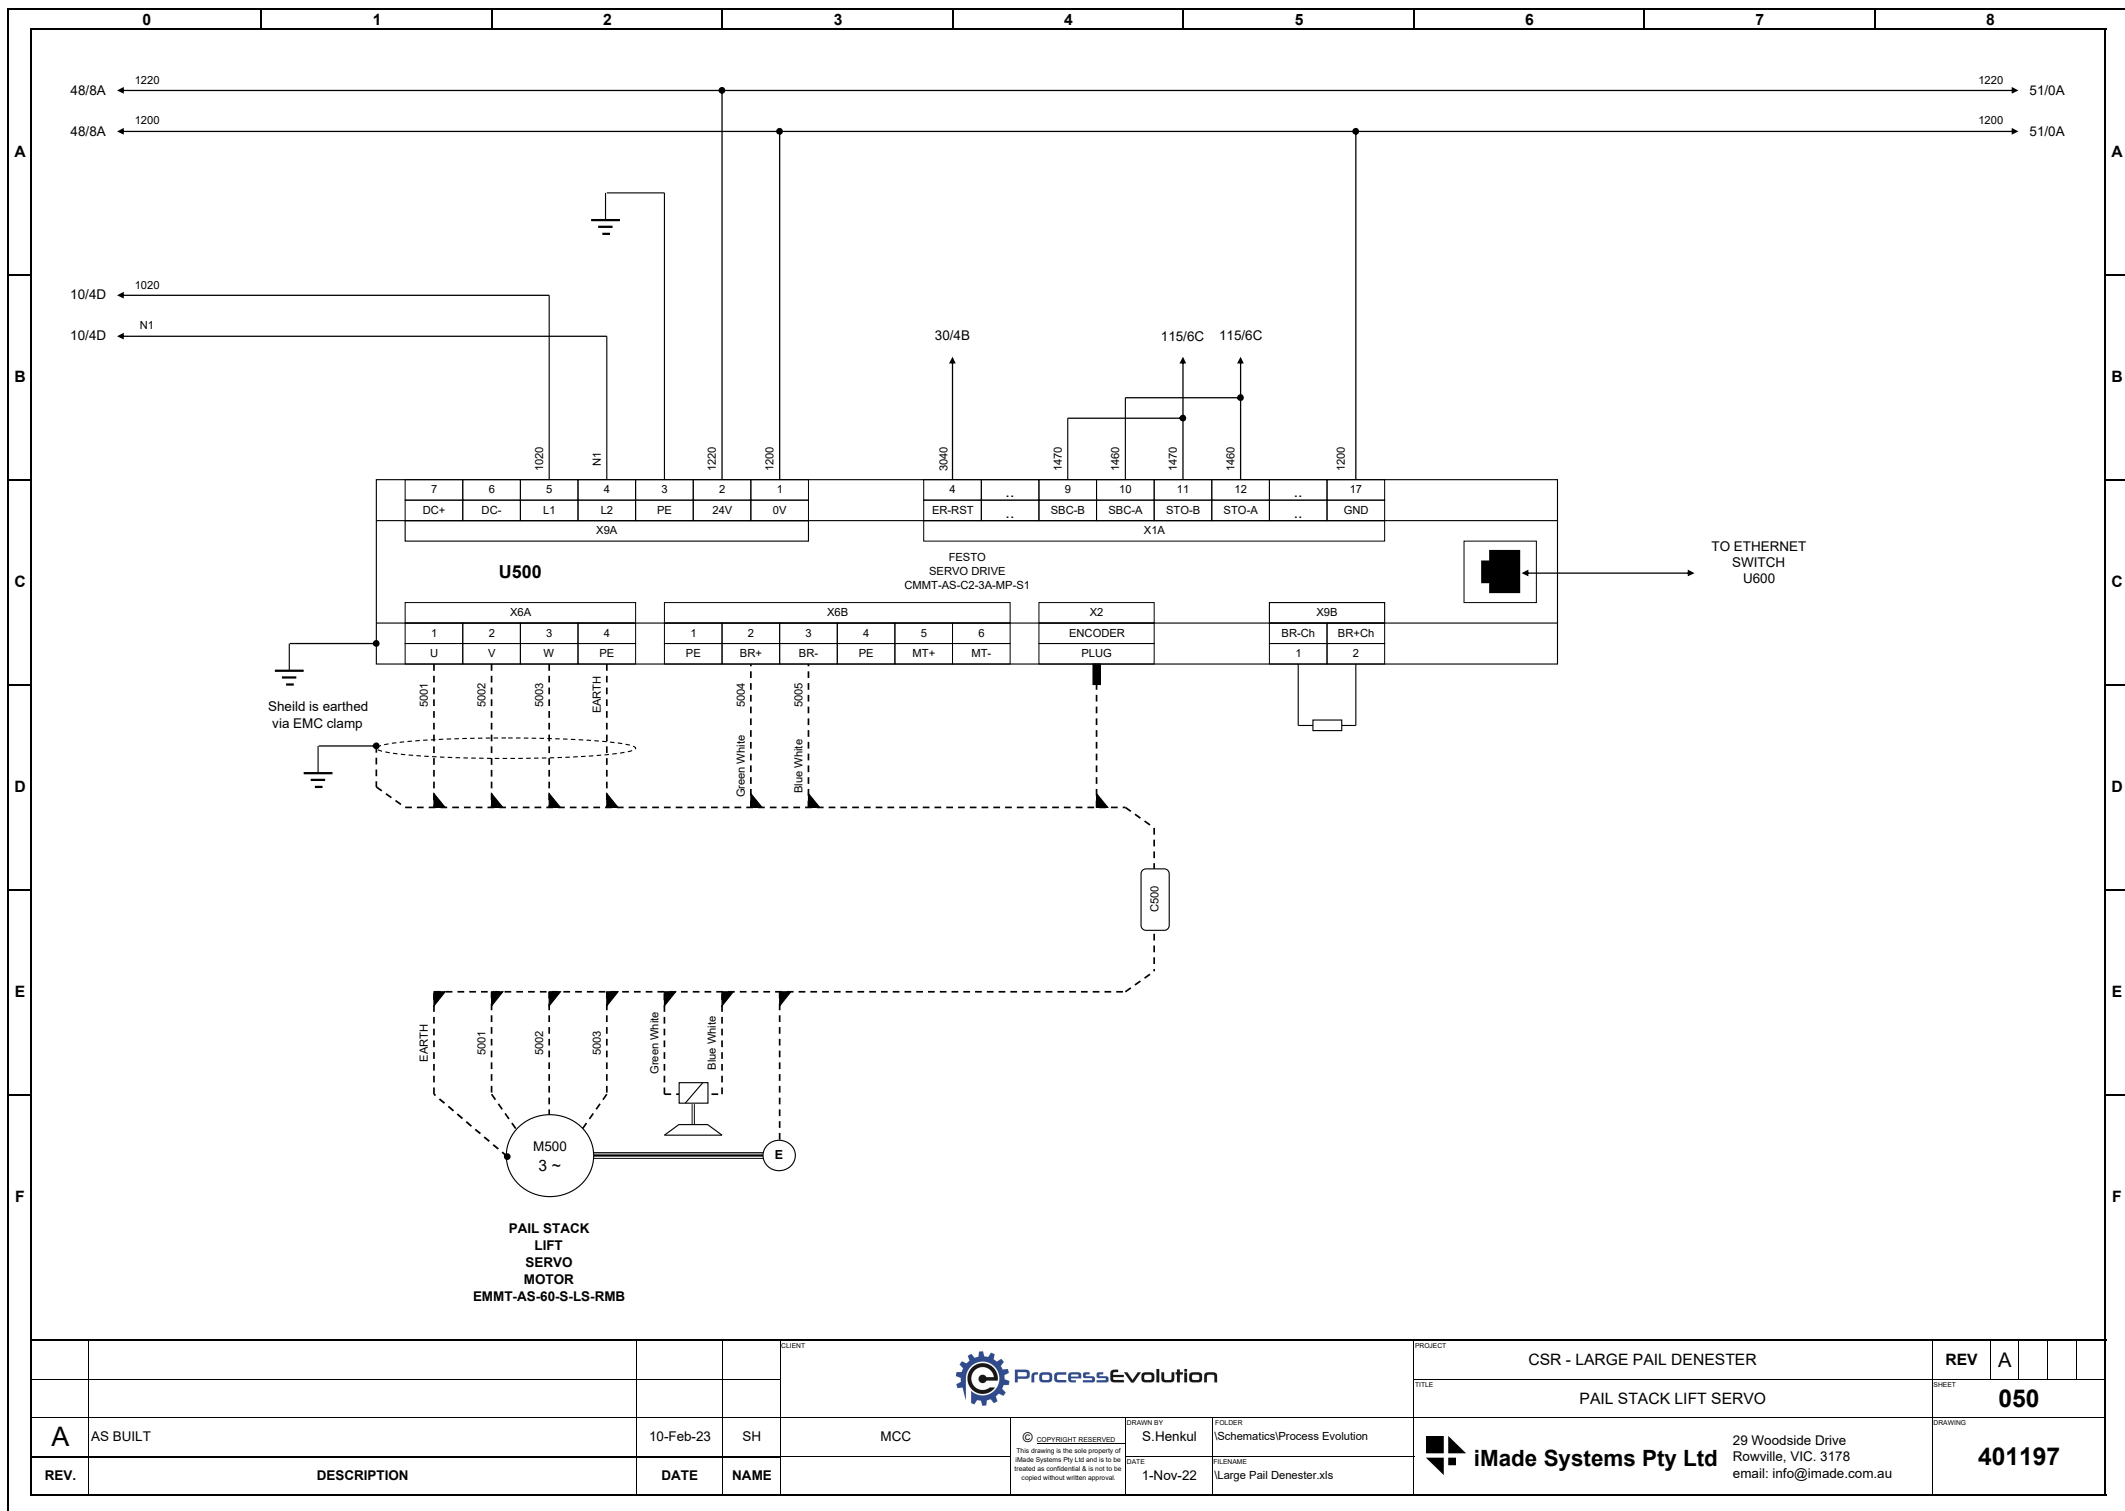


PROJECT	CSR - LARGE PAIL DENESTER	REV	A		
TITLE	PAIL STACK LIFT SERVO	SHEET	050		
DRAWING					

REV.	DESCRIPTION	DATE	NAME
A	AS BUILT	10-Feb-23	SH

CLIENT	MCC
DRAWN BY	S.Henkul
DATE	1-Nov-22
FOLDER	ISchematics\Process Evolution
FILENAME	Large Pail Denester.xls

**iMade Systems Pty Ltd**  
29 Woodside Drive  
Rowville, VIC. 3178  
email: info@imade.com.au

**401197**

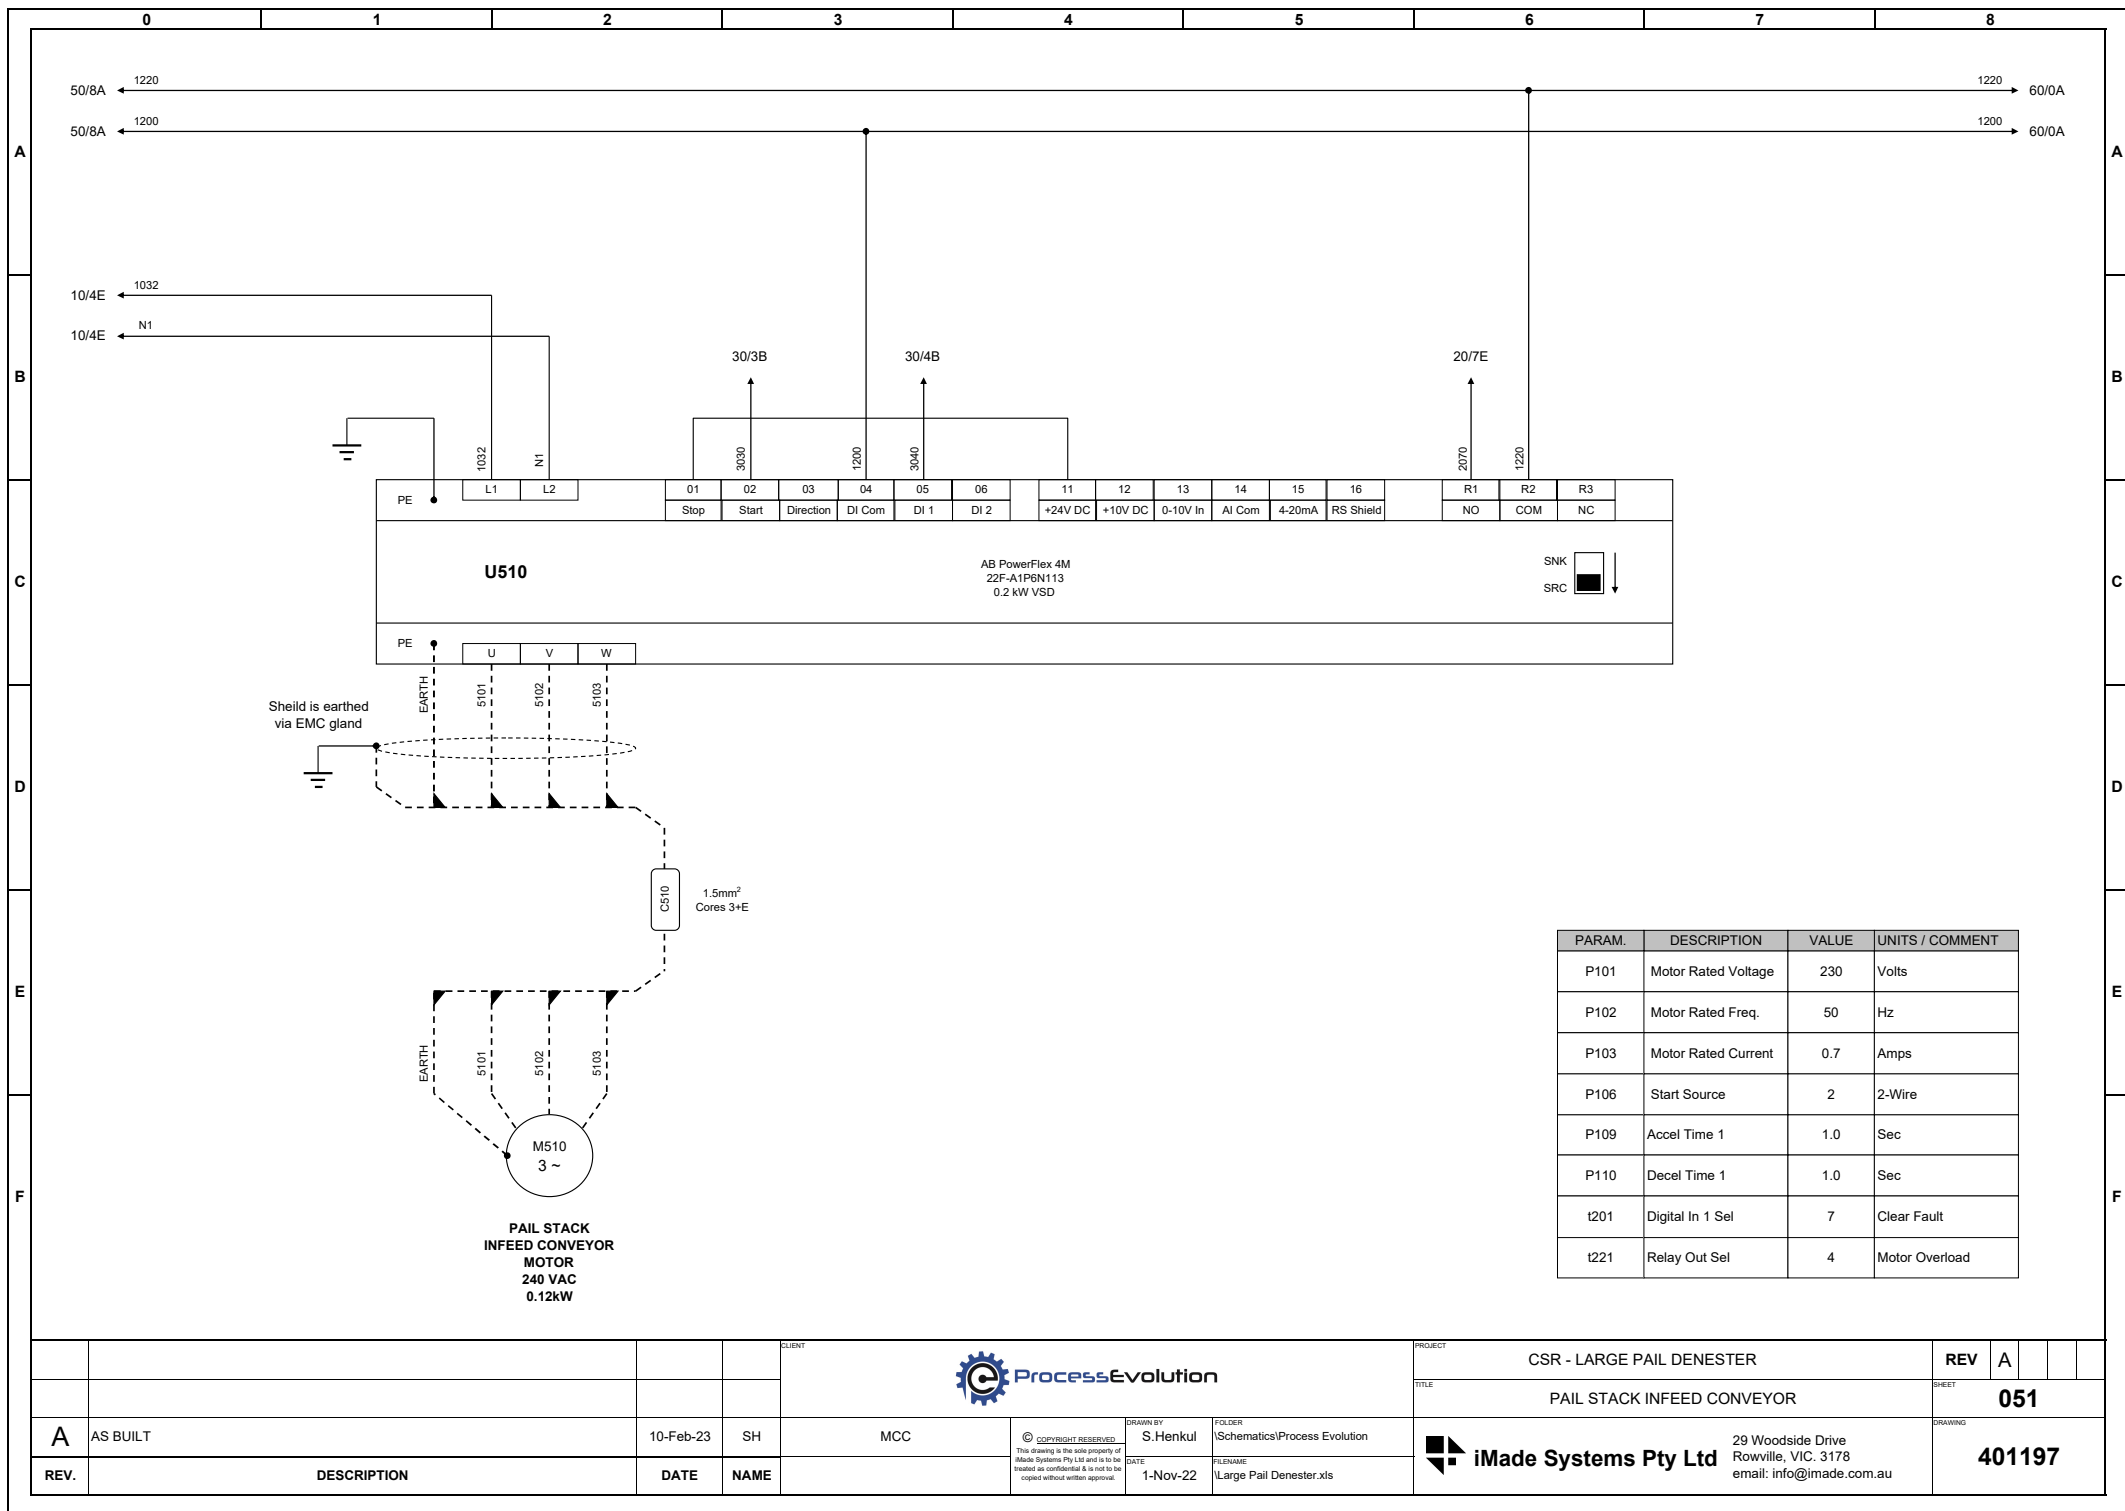

© COPYRIGHT RESERVED  
This drawing is the sole property of  
iMade Systems Pty Ltd and is to be  
treated as confidential & is not to be  
copied without written approval.

DRAWN BY  
S.Henkul  
DATE  
1-Nov-22

FOLDER  
Schematics/Process Evolution  
FILENAME  
Large Pail Denester.xls



iMade Systems Pty Ltd


29 Woodside Drive  
Rowville, VIC. 3178  
email: info@imade.com.au


REV A  
SHEET 051  
DRAWING 401197








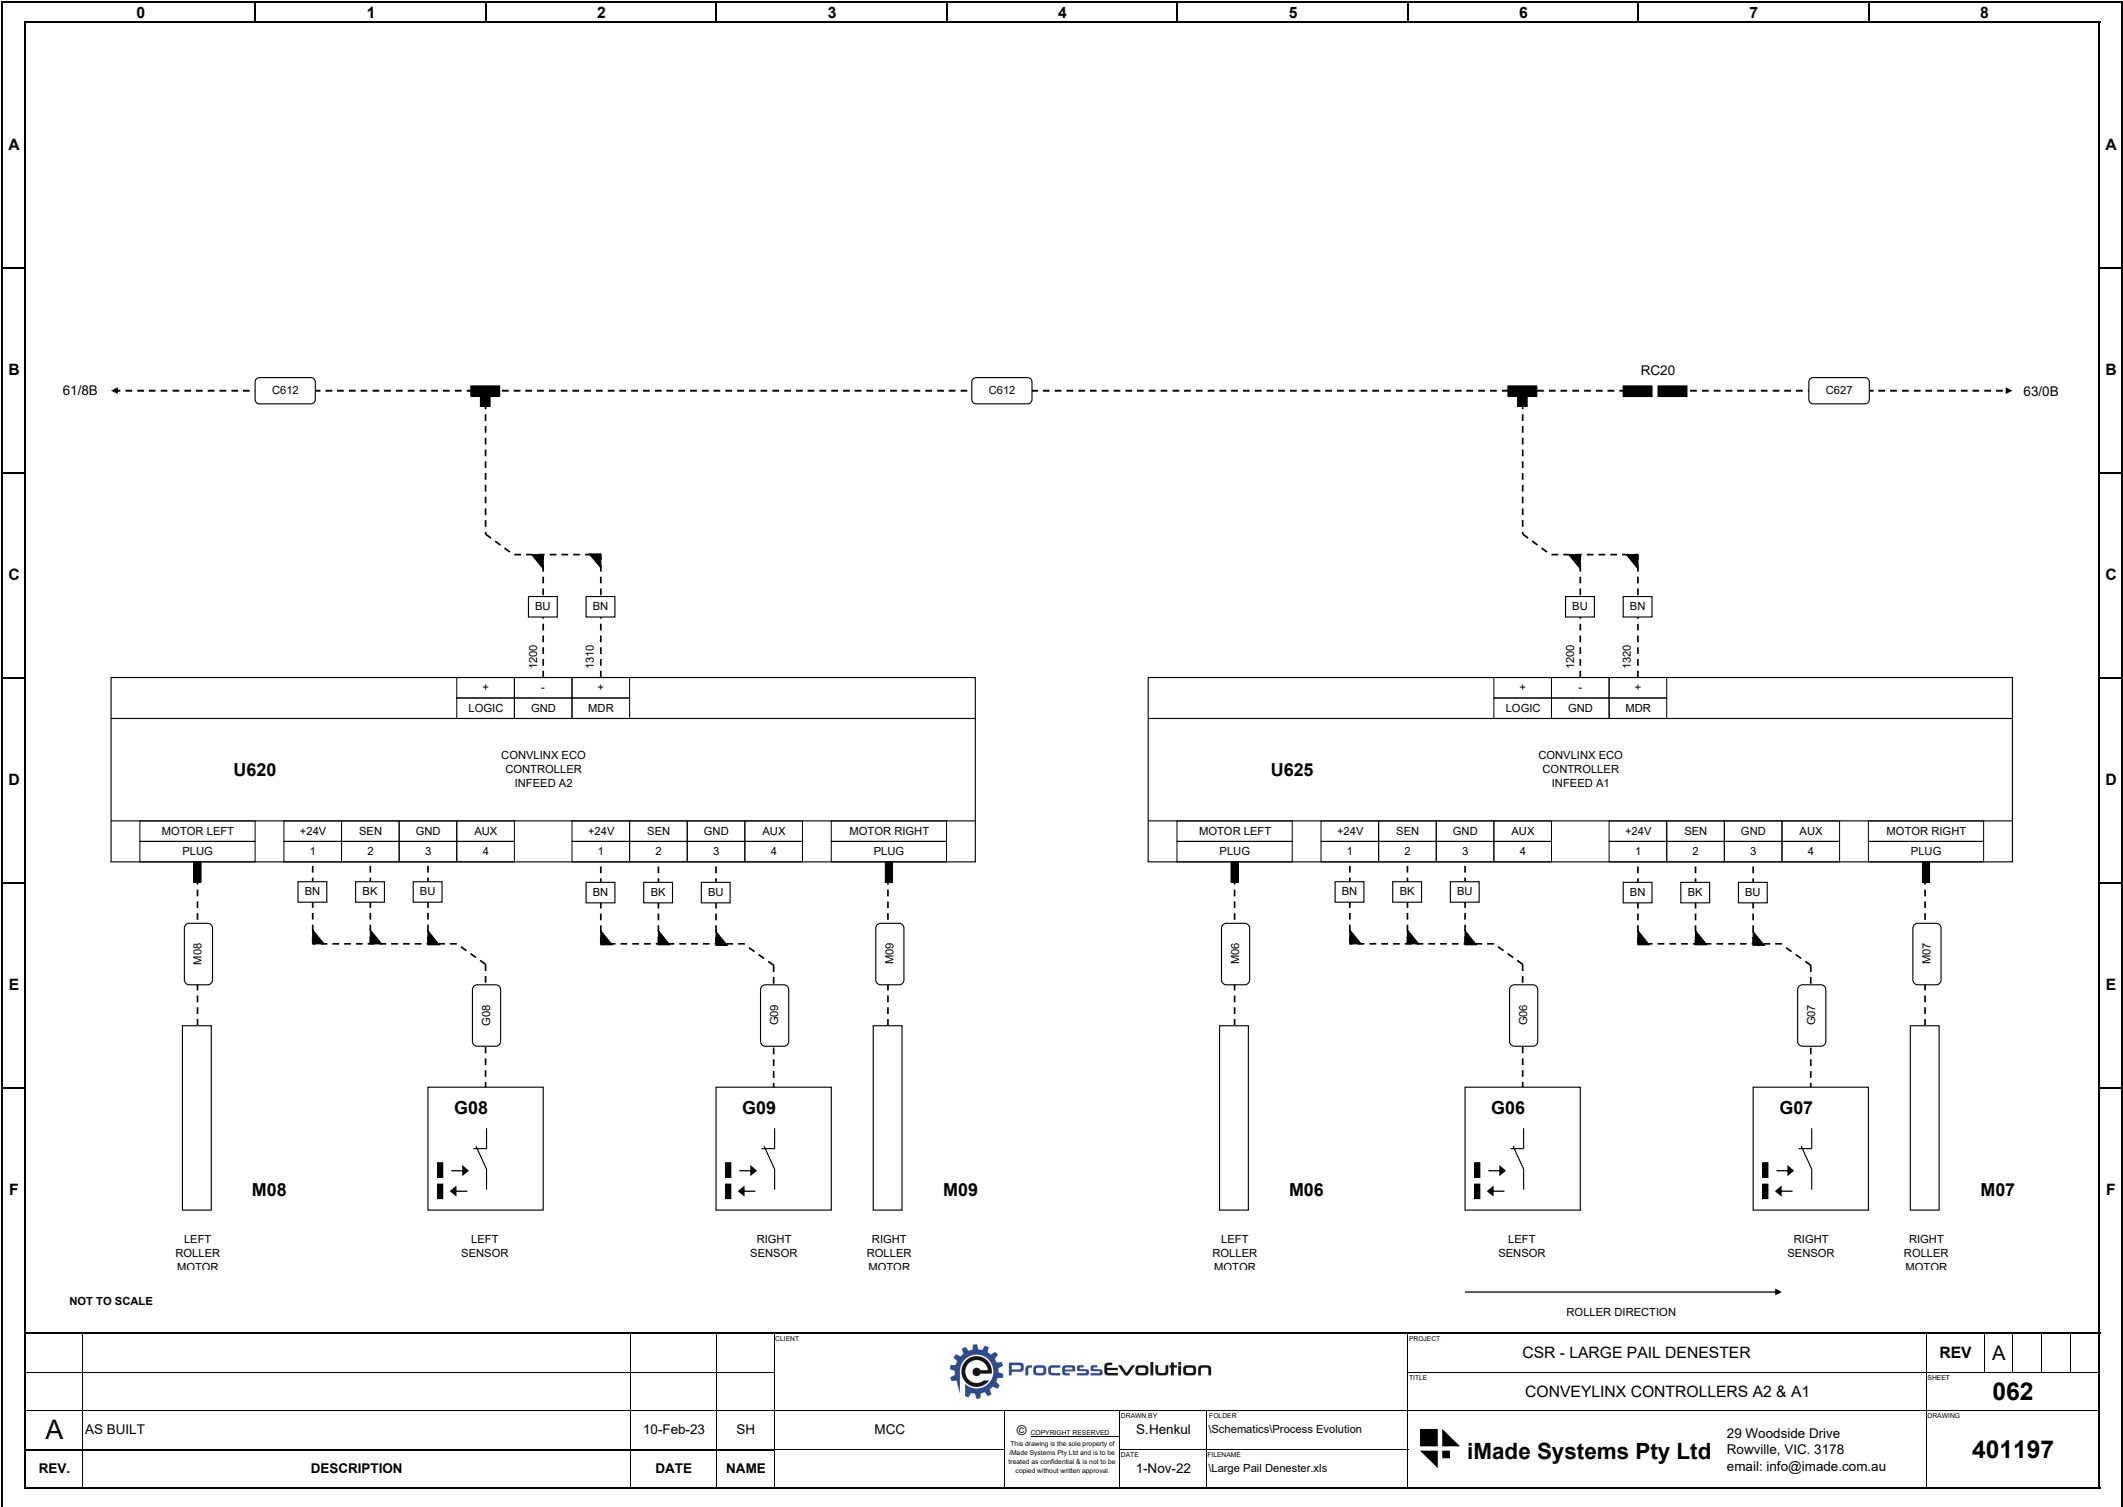

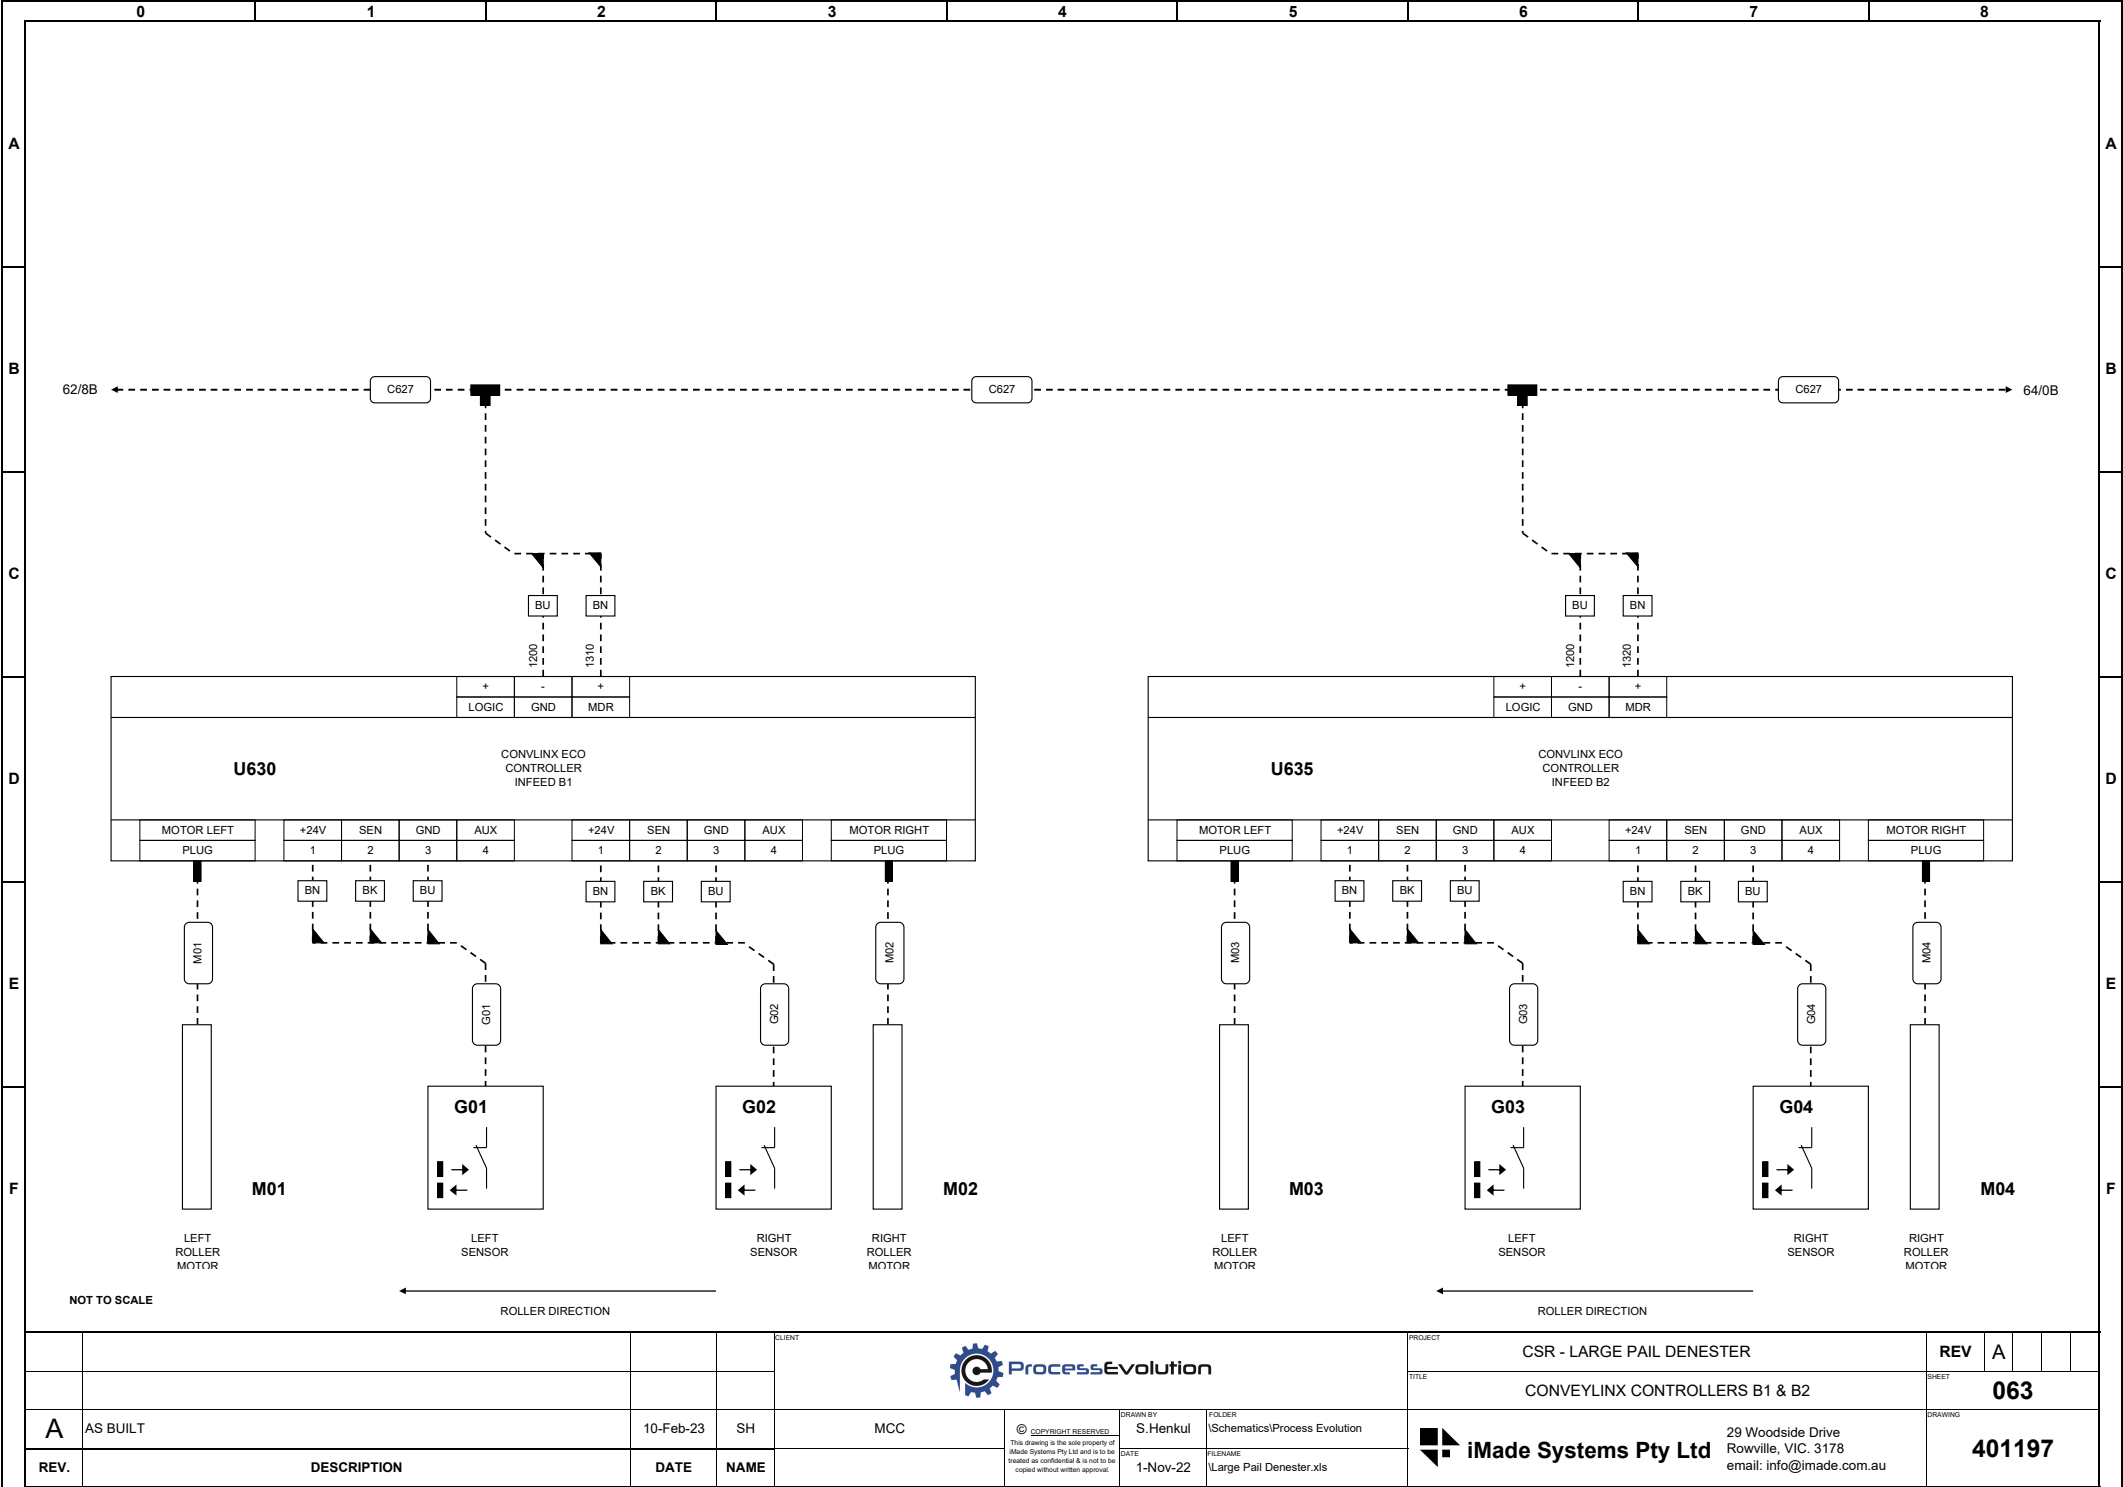

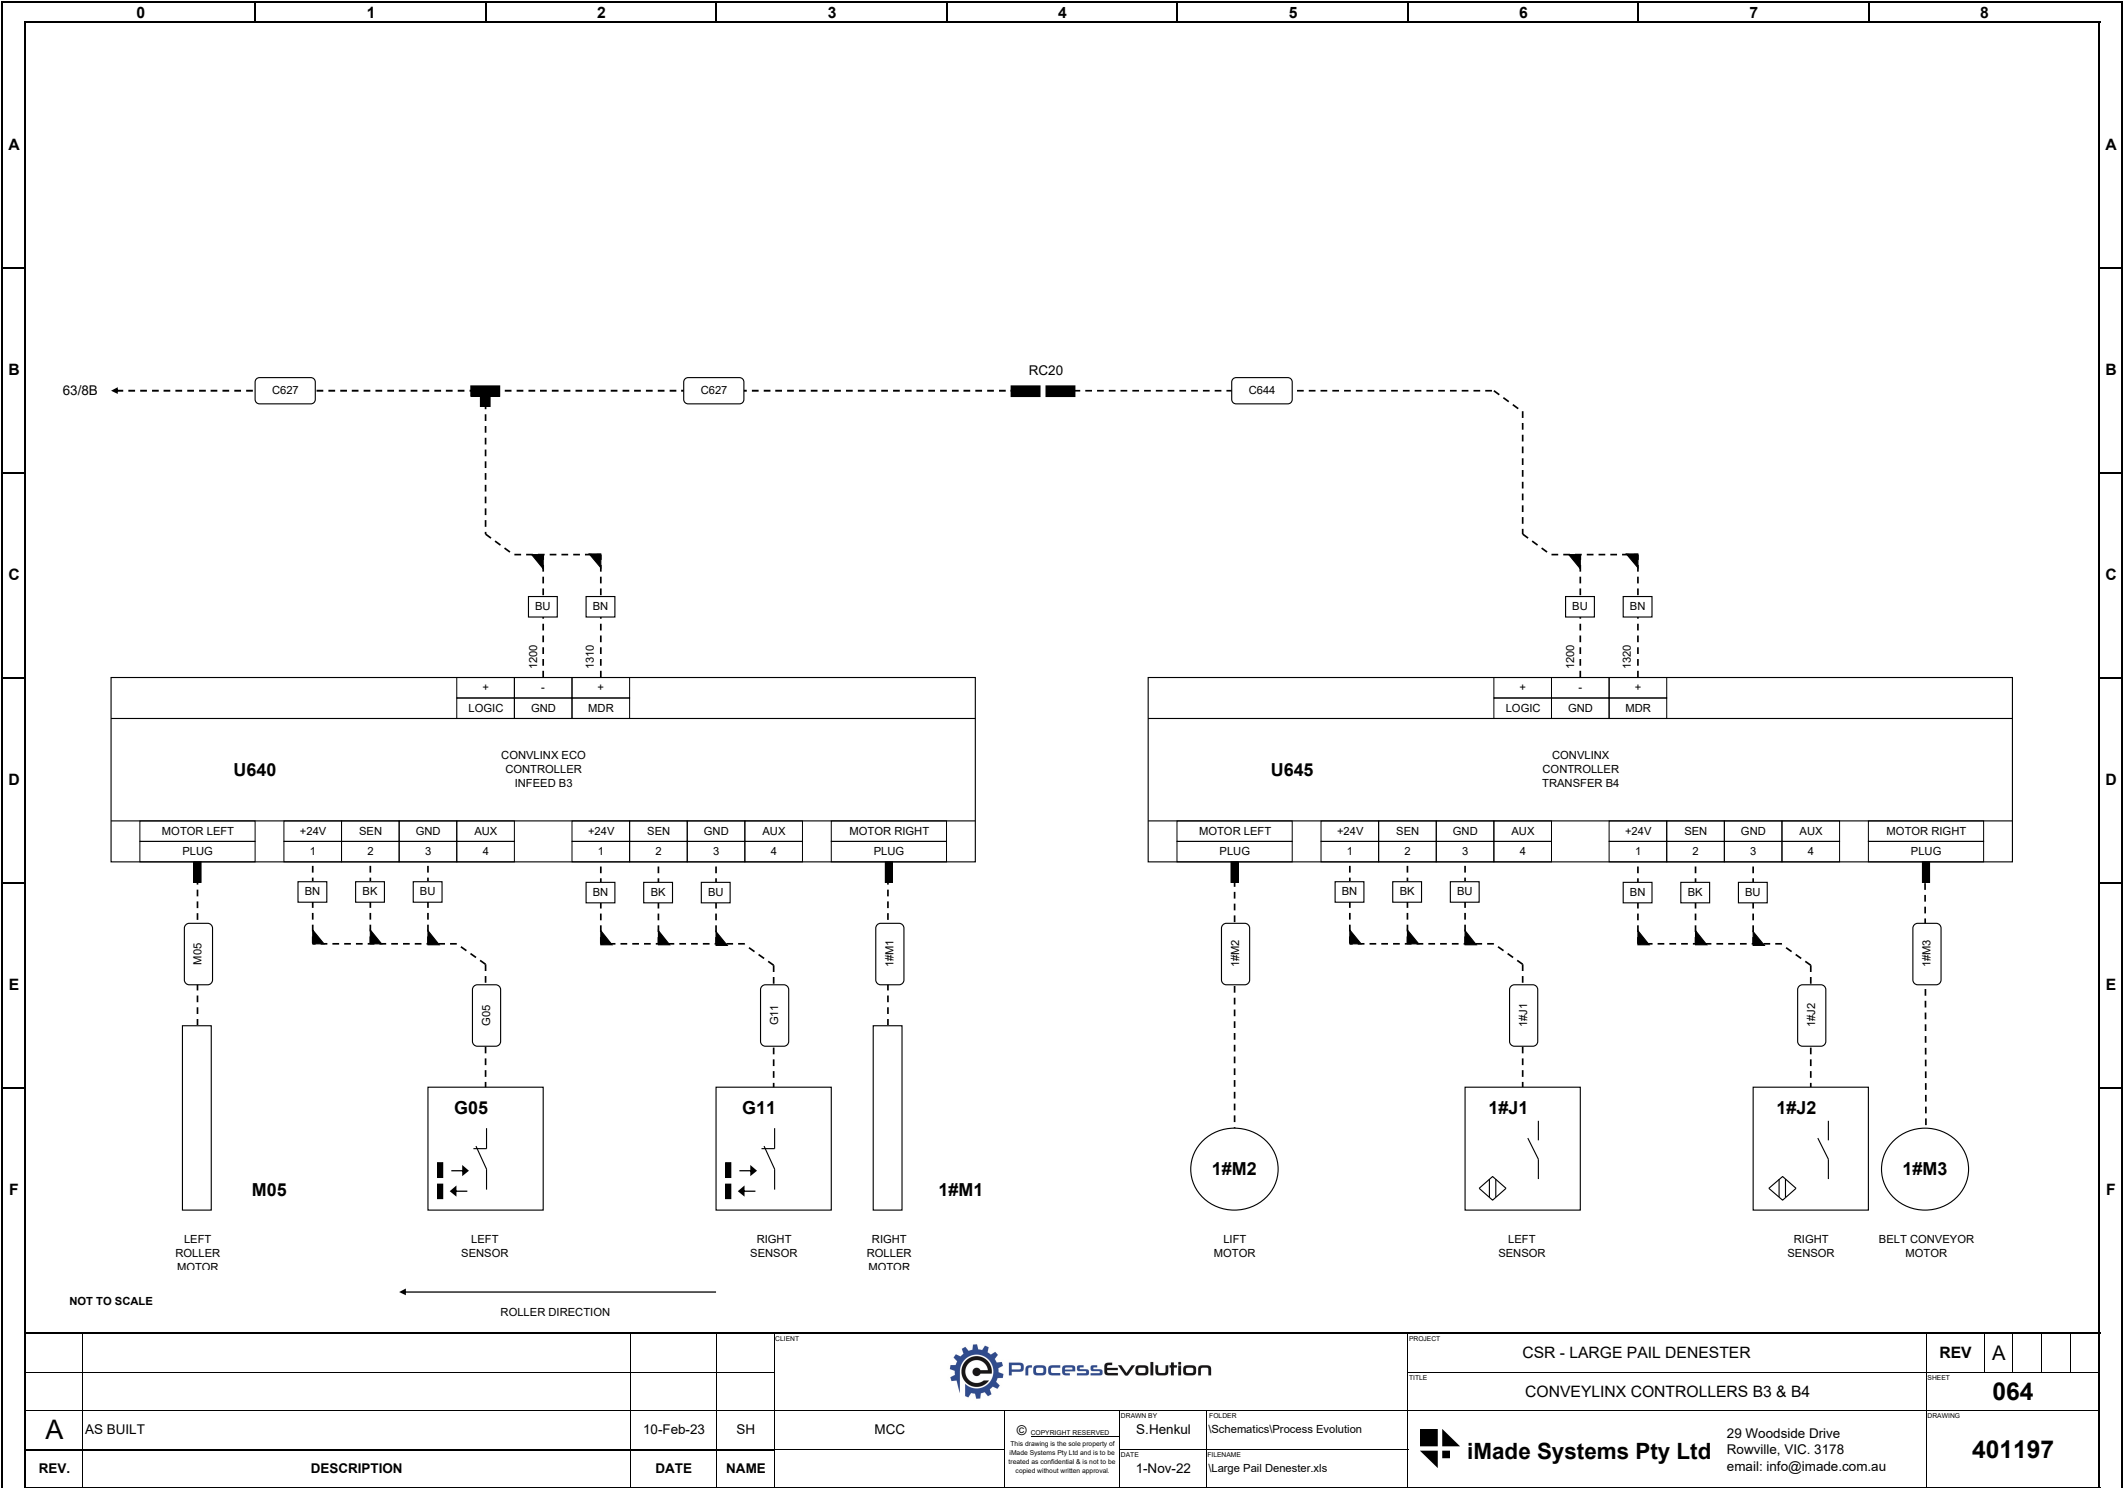

PROJECT	CSR - LARGE PAIL DENESTER			REV	A		
TITLE	CONVEYLINX CONTROLLERS B3 & B4			SHEET	064		
DRAWN BY	S.Henkul			DRAWING	401197		
FOLDER	ISchematics\Process Evolution						
FILENAME	Large Pail Denester.xls						
DATE	1-Nov-22						



**iMade Systems Pty Ltd**  
29 Woodside Drive  
Rowville, VIC. 3178  
email: info@imade.com.au